

WALTHALL  
C63  
1-29-73

MISSISSIPPI  
BOARD OF WATER COMMISSIONERS  
416 North State Street  
Jackson, Mississippi 39201

WATER WELL DRILLERS LOG

Jan 29 1973 Chester Reeves Walthall  
date well completed firm name county well located

LANDOWNER: Johnnie  
Phillips  
473 Tyler town  
(mailing address)

WELL LOCATION:  
sec. 6 T. 3 N. R. 10 E.  
4 miles SE Prudhoe  
(distance) (direction) (nearest town)

WELL PURPOSE: House  
(home, irrigation, municipal, industrial)

WELL COMPLETION DATA:  
(1) diameter (inches) 4 1/2"  
(2) total depth (feet) 92  
(3) static water level (feet) 29 below top of ground.  
(4) casing Plat bottom  
(material) (depth)  
(size) if telescope see back.  
(5) screen 6' 86'  
(length) (depth to top)  
4 1/2" Plat  
(size) (material)  
(6) pump 1/2 HP 15  
(HP) (yield gpm)  
Electric  
(type power)  
(7) electric log NO  
(yes or no)

(organization running log)

(8) how well bottom plugged  
wooden plug

DRILLERS REMARKS:  
New location

description of formation encountered	from	to
<u>Gravel &amp; clay</u>	<u>0</u>	<u>18</u>
<u>lumpy chalk</u>	<u>18</u>	<u>46</u>
<u>lumpy</u>	<u>46</u>	<u>78</u>
<u>coarse sand &amp; pea gravel</u>	<u>78</u>	<u>92</u>

CODED


CODED

APR 20 1973

PAGE NO. OF

If well telescopes please sketch and show depths.

GROUND LEVEL

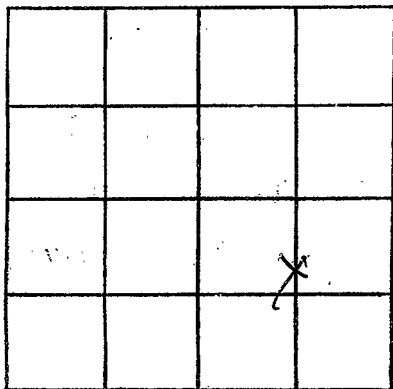

SECTION 6

Please indicate well location X.

ADDITIONAL INFORMATION

If more than one screen,  
show locations of each on sketch.