

11-11-73  
**CODED**

WALTHALL  
C 64  
1-4-73

MISSISSIPPI  
BOARD OF WATER COMMISSIONERS  
416 North State Street  
Jackson, Mississippi 39201

WATER WELL DRILLERS LOG

Jan 4 1973 Chester Reeves Walthall  
date well completed firm name county well located

LANDOWNER: Stennis Plenum  
Rt 3, Tylerhaven  
(mailing address)

description of formations encountered	from	to
Red clay	0	17
Red sand	17	52
Sand & gravel	52	80
Sandy sand	80	105
Red sandy chalk	105	128
Red gravel & sand	128	140

WELL LOCATION:  
sec. 7 T. 3 N. R. 10 E  
4 miles SE Princeton  
(distance) (direction) (nearest town)

WELL PURPOSE: Home  
(home, irrigation, municipal, industrial)

- WELL COMPLETION DATA:
- (1) diameter (inches) 4"
  - (2) total depth (feet) 140
  - (3) static water level (feet) 85 below top of ground.
  - (4) casing Plast Galv  
(material) (depth)
  - (size) If telescope see back.
  - (5) screen 6' 130'  
(length) (depth to top)
  - 4" Plast  
(size) (material)
  - (6) pump 1/2 Sub 12  
(HP) (yield gpm)
  - Electric  
(type power)
  - (7) electric log NO  
(yes or no)
  - (organization running log)

**CODED**


(8) how well bottom plugged  
water plug

DRILLERS REMARKS:  
NO previous well.

APR 2 1973

If well telescopes please sketch and show depths.

GROUND LEVEL

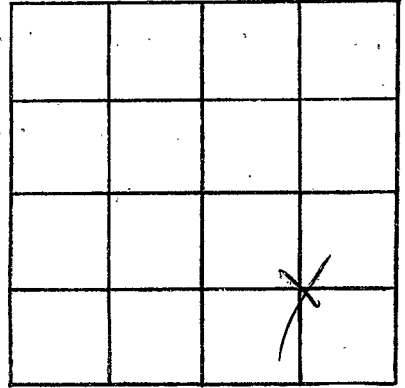

SECTION 7

Please indicate well location X.

ADDITIONAL INFORMATION

If more than one screen,  
show locations of each on sketch.