

WALTHALL
C65
5-30-73

MISSISSIPPI
BOARD OF WATER COMMISSIONER
416 North State Street
Jackson, Mississippi 39201

CODED

WATER WELL DRILLERS LOG

5-30 1973 Fitzgerald well serv Walthall
date well completed firm name county well located

LANDOWNER:

Timothy Deer
RR. 1, Hylton, Miss.
(mailing address)

description of formations encountered

from to

<u>Red clay</u>	<u>0</u>	<u>20</u>
<u>Red sand</u>	<u>20</u>	<u>100</u>
<u>Coarse sand & gravel</u>	<u>100</u>	<u>118</u>

WELL LOCATION:

sec. 17 T. 30 R. 10
11 S. 3 W. 18 W.
10 miles N of Hylton
(distance) (direction) (nearest town)

WELL PURPOSE:

Home
(home, irrigation, municipal, industrial)

WELL COMPLETION DATA:

- (1) diameter (inches) 4
- (2) total depth (feet) 111
- (3) static water level (feet) 90 below above top of ground.
- (4) casing plastic 103
(material) (depth)
4 if telescope see back.
(size)
- (5) screen 3, 103
(length) (depth to top)
4, plastic
(size) (material)
- (6) pump 1/2, 10
(HP) (yield gpm)
El
(type power)
- (7) electric log ny
(yes or no)
(organization running log)
- (8) how well bottom plugged absolutely


CODED

DRILLERS REMARKS:

JUN 28 1973

If well telescopes please sketch and show depths.

GROUND LEVEL

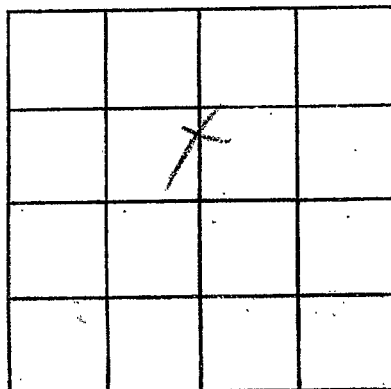

SECTION

Please indicate well location X.

ADDITIONAL INFORMATION

If more than one screen, show locations of each on sketch.