

WALTHALL  
C 66  
7-23-73

MISSISSIPPI  
BOARD OF WATER COMMISSIONERS  
416 North State Street  
Jackson, Mississippi 39201

CODED

WATER WELL DRILLERS LOG

29 May 1973 A.T. Cooney & Son Walthall  
date well completed firm name county well located

LANDOWNER:  
Clyde A. Carbaugh  
Tylertown  
(mailing address)

description of formations encountered	from	to
Clay	0	20
red clay	20	60
Shale	50	100
Sand	100	195

WELL LOCATION:  
sec. 3 T. 3 N. R. 10 E  
6 miles N of Tylertown  
(distance) (direction) (nearest town)

WELL PURPOSE:  
(home, irrigation, municipal, industrial)

WELL COMPLETION DATA:

- (1) diameter (inches) 4
- (2) total depth (feet) 195
- (3) static water level (feet) 110 below top of ground.
- (4) casing (material) PL (depth) 189  
(size) if telescope see back.
- (5) screen (length) 6 (depth to top) 189  
(size) 4 (material) PL
- (6) pump (HP) 1/2 (yield gpm) 8  
(type power) dit
- (7) electric log (yes or no)
- (organization running log)
- (8) how well bottom plugged wood


CODED

DRILLERS REMARKS:

17 1973

If well telescopes please sketch and show depths.

GROUND LEVEL

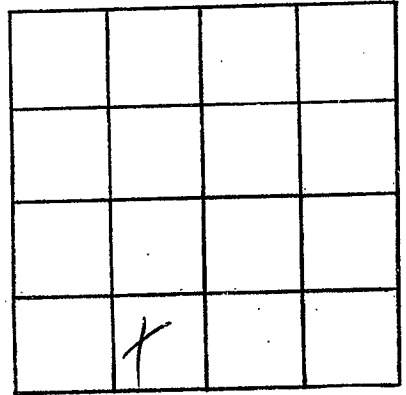

SECTION 3

Please indicate well location X.

ADDITIONAL INFORMATION

If more than one screen, show locations of each on sketch.