

CODED

MISSISSIPPI  
BOARD OF WATER COMMISSIONERS  
416 North State Street  
Jackson, Mississippi 39201

WATER WELL DRILLERS LOG

C 67  
WALTHALL  
7-31-73

7-31

date well completed

1973

Hydrolabel Inc

firm name


Walthall

county well located

LANDOWNER:	description of fomations encountered	from	to
Ray Richman			
R.R. Hyattman, Jr. (mailing address)	Red clay Red sand Coarse sand & gravel	0 20 85	20 85 95
WELL LOCATION:			
sec. 2 / T. 30 <sup>N</sup> / R. 10 <sup>E</sup> 8 miles N of Tylab (distance) (direction) (nearest town)			
WELL PURPOSE: (home, irrigation, municipal, industrial)			
Home			
WELL COMPLETION DATA:			
(1) diameter (inches) 4			
(2) total depth (feet) 95			
(3) static water level (feet) 63 below above top of ground.			
(4) casing (material) plastic, (depth) 37			
4 (size) if telescope see back.			
(5) screen (length) 8, (depth to top) 87			
4 (size), plastic (material)			
(6) pump (HP) 1/2, (yield gpm) 10			
elm (type power)			
(7) electric log (yes or no) <input checked="" type="checkbox"/>			
(organization running log)			
(8) how well bottom plugged <u>wood per</u>			
DRILLERS REMARKS:			

If well telescopes please sketch and show depths.

GROUND LEVEL

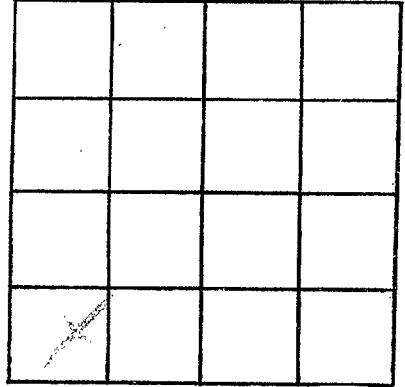

SECTION 21

Please indicate well location X.

ADDITIONAL INFORMATION

If more than one screen,  
show locations of each on sketch.