

WALTHALL
C 68
10-1-73

MISSISSIPPI
BOARD OF WATER COMMISSIONERS
416 North State Street
Jackson, Mississippi 39201

CODED

WATER WELL DRILLERS LOG

10-1
date well completed

1973

Thywell Well Serv
firm name

Walthall


county well located

LANDOWNER:	description of formations encountered	from	to
Jim Smith R.R. Lytle (mailing address)			
WELL LOCATION: sec. 32 30 R 1 S W 6 miles W of Lytle (distance) (direction) (nearest town)			
WELL PURPOSE: (home, irrigation, municipal, industrial)			
WELL COMPLETION DATA: (1) diameter (inches) 4 (2) total depth (feet) 117 (3) static water level (feet) 75 below top of ground. (4) casing plastic, 109 (material) (depth) 4 (size) if telescope see back. (5) screen 8 (length) 109 (depth to top) 4 (size) plastic (material) (6) pump 1/2 (HP) 10 (yield gpm) Elec (type power) (7) electric log No (yes or no) (organization running log) (8) how well bottom plugged full plug	CODED		
DRILLERS REMARKS:			

OCT 9 1973

If well telescopes please sketch and show depths.

GROUND LEVEL

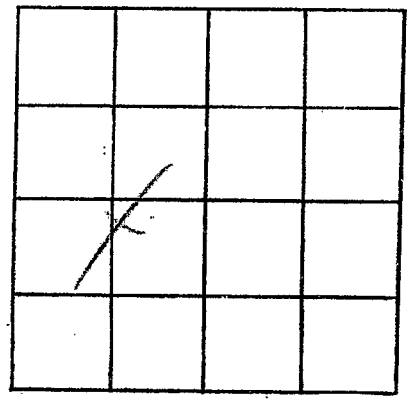

SECTION 32

Please indicate well location X.

ADDITIONAL INFORMATION

A series of horizontal lines for writing additional information, starting below the 'ADDITIONAL INFORMATION' header and extending to the bottom of the page.

If more than one screen, show locations of each on sketch.