

WALTHALL
C69
9-10-73

MISSISSIPPI
BOARD OF WATER COMMISSIONERS
416 North State Street
Jackson, Mississippi 39201

CODED

WATER WELL DRILLERS LOG

9-10 1973 *red water well* *Walthall*
date well completed firm name county well located

LANDOWNER:
David Conally
Conally
Yuletown Miss
(mailing address)

WELL LOCATION:
sec. *16* T. *3* N. R. *10* E. W. *10* S.
8 1/2 miles *west* *Yuletown*
(distance) (direction) (nearest town)

WELL PURPOSE:
(home, irrigation, municipal, industrial)

WELL COMPLETION DATA:

(1) diameter (inches) *4"*

(2) total depth (feet) *95*

(3) static water level (feet) *78* below above top of ground.

(4) casing *4" PVC* *85*
(material) (depth)
(size) if telescope see back.

(5) screen *10'* *85'*
(length) (depth to top)
.012 *sch 40 PVC*
(size) (material)

(6) pump *1/2* *8*
(HP) (yield gpm)
220 volt
(type power)

(7) electric log *(yes or no)*
(organization running log)

(8) how well bottom plugged
1' gravel pack below

description of formations encountered	from	to
<i>Top clay</i>	<i>0</i>	<i>20</i>
<i>Clay + sand</i>	<i>20</i>	<i>40</i>
<i>Coarse sand</i>	<i>40</i>	<i>48</i>
<i>fine gravel</i>	<i>58</i>	<i>60</i>
<i>fine sand</i>	<i>60</i>	<i>68</i>
<i>gravel</i>	<i>68</i>	<i>76</i>
<i>red chalk</i>	<i>76</i>	<i>80</i>
<i>Coarse sand</i>	<i>80</i>	<i>95</i>

CODED


SEPT 29 1973

MISS. BU.
LEWIS CO.

DRILLERS REMARKS:

If well telescopes please sketch and show depths.

GROUND LEVEL

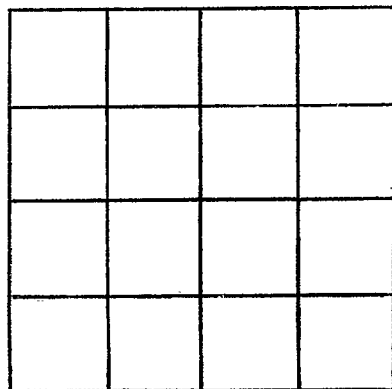

SECTION _____

Please indicate well location X.

ADDITIONAL INFORMATION

If more than one screen,
show locations of each on sketch.