

WALTHALL
C 71
1-15-74

MISSISSIPPI
 BOARD OF WATER COMMISSIONERS
 416 North State Street
 Jackson, Mississippi 39201

CODED

WATER WELL DRILLERS LOG

1-15 1974 Fidelity Well Service Walthall
 date well completed firm name county well located

LANDOWNER:

Rose Hill Methodist Church

R.P. Fidelity
 (mailing address)

description of formations encountered

from

to

Red Clay
Red Brown

2 20
22 140

WELL LOCATION:

sec. 29 T. 3 N. R. 10 E.
5 miles NW of Fidelity
 (distance) (direction) (nearest town)

WELL PURPOSE:

Home
 (home, irrigation, municipal, industrial)

WELL COMPLETION DATA:

- (1) diameter (inches) 4
- (2) total depth (feet) 140
- (3) static water level (feet) 100 below top of ground.
- (4) casing plastic, 132
 (material) (depth)
4 if telescope see back.
 (size)
- (5) screen 8, 132
 (length) (depth to top)
4, plastic
 (size) (material)
- (6) pump 1/2, 10
 (HP) (yield gpm)
Electric
 (type power)
- (7) electric log no
 (yes or no)
- (8) how well bottom plugged sand slat


CODED

DRILLERS REMARKS:

REGISTERED
JAN 26 1974

If well telescopes please sketch and show depths.

GROUND LEVEL

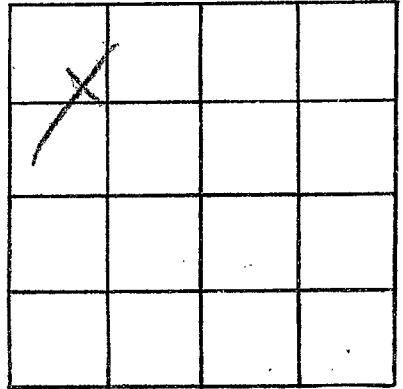

SECTION 29

Please indicate well location X.

ADDITIONAL INFORMATION

If more than one screen,
show locations of each on sketch.