

WALTHALL  
C 72  
9/73

MISSISSIPPI  
BOARD OF WATER COMMISSIONERS  
416 North State Street  
Jackson, Mississippi 39201

CODED

WATER WELL DRILLERS LOG

Sept. 23 1973 E. B. Sherrard Walthall  
date well completed firm name county well located

LANDOWNER:  
Willis Holmes  
Zulutown, Ms.  
(mailing address)

description of formations encountered	from	to
LOOSE SANDY		
HEAVY CLAY	0	60
CLAY + SAND		
OTHEAKS	60	90
SAND + GRAVEL		
WITH CLAY STAKE	90	150
PEA GR. + SAND	150	182

WELL LOCATION:  
sec. 7 T 3 N R 10 E  
S W  
10 miles NW Zulutown  
(distance) (direction) (nearest town)

WELL PURPOSE:  
(home irrigation, municipal, industrial)

- WELL COMPLETION DATA:
- diameter (inches) 2"
  - total depth (feet) 182'
  - static water level (feet) 70' below top of ground.
  - casing (material) pl. (depth) 177'
  - 2" if telescope see back. (size)
  - screen 5' (length) (depth to top)
  - 2" (size) pl. (material)
  - pump 1 (HP) 8 (yield gpm)
  - E (type power)
  - electric log (yes or no)
  - (organization running log)
  - how well bottom plugged BWV


CODED

DRILLERS REMARKS:

FEB 8 1974  
MISS. Bd. OF WATER COMMISSIONERS

If well telescopes please sketch and show depths.

GROUND LEVEL

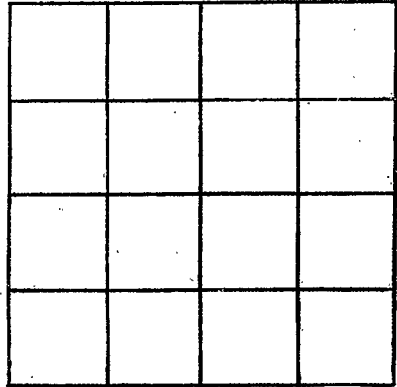

SECTION \_\_\_\_\_

Please indicate well location X.

ADDITIONAL INFORMATION

If more than one screen,  
show locations of each on sketch.