

WALTHALL
C 74
5-17-73

MISSISSIPPI
BOARD OF WATER COMMISSIONERS
416 North State Street
Jackson, Mississippi 39201

WATER WELL DRILLERS LOG

May 17 1973 date well completed
Chute Keene firm name
Walthall county well located

LANDOWNER

Eleptus
Aford

description of formations
encountered

from

to

Rt 5, Tylertown
(mailing address)

Red clay

0 25

Red sand

25 72

Sand & gravel

72 98

Slightly sand & gravel

98 121

Small gravel & sand

121 134

WELL LOCATION:

sec. 24 T 3 N R 10 E
6 miles N Tylertown
(distance) (direction) (nearest town)

WELL PURPOSE: Hand
(home, irrigation, municipal, industrial)

WELL COMPLETION DATA:

- (1) diameter (inches) 4"
- (2) total depth (feet) 134'
- (3) static water level (feet) 100 below
top of ground. above
- (4) casing Plast. Bottom
(material) (depth)
- (size) if telescope see back.
- (5) screen 6' 128'
(length) (depth to top)
- 4" Plast
(size) (material)
- (6) pump 1/2 Sub - 12
(HP) (yield gpm)
- 220
(type power)
- (7) electric log NO
(yes or no)

(organization running log)

(8) how well bottom plugged

Wooden plug

DRILLERS REMARKS:

New location


CODED

RECEIVED
MAY 24 1973

MAY 24 1973

If well telescopes please sketch and show depths.

GROUND LEVEL

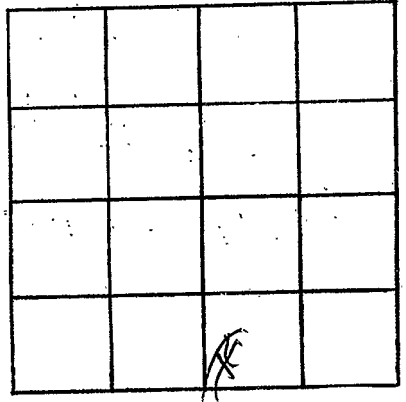

SECTION 24

Please indicate well location X.

ADDITIONAL INFORMATION

If more than one screen, show locations of each on sketch.