

WALTHALL
 E 75
 5-10-73

MISSISSIPPI
 BOARD OF WATER COMMISSIONERS
 416 North State Street
 Jackson, Mississippi 39201

CODED

WATER WELL DRILLERS LOG

May 10 1973 Chester Keene Walthall
 date well completed firm name county well located

LANDOWNER: Walter Alfred
H-3 - Tyler town

description of formations encountered	from	to
Red Clay	0	22
Red Sand	22	107
Sand & gravel	107	120

(mailing address)

WELL LOCATION:

sec. 14 T. 3 N R. 10 E
6 miles N of Tyler town
 (distance) (direction) (nearest town)

WELL PURPOSE: Home
 (home, irrigation, municipal, industrial)

CODED


WELL COMPLETION DATA:

- (1) diameter (inches) 4 1/2"
- (2) total depth (feet) 120'
- (3) static water level (feet) 98 below/above top of ground.
- (4) casing Plast Bottom
 (material) (depth)
- (size) If telescope see back.
- (5) screen 6' 114'
 (length) (depth/to top)
- (size) 4" Plast
 (material)
- (6) pump 1/2 HP 17
 (HP) (yield gpm)
- (type power) Elect
- (7) electric log NO
 (yes or no)

(organization running log)

(8) how well bottom plugged
wooden plug


DRILLERS REMARKS:
old well had

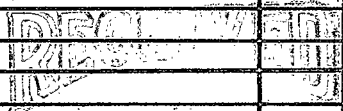

MAY 24 1973

If well telescopes please sketch and show depths.

GROUND LEVEL

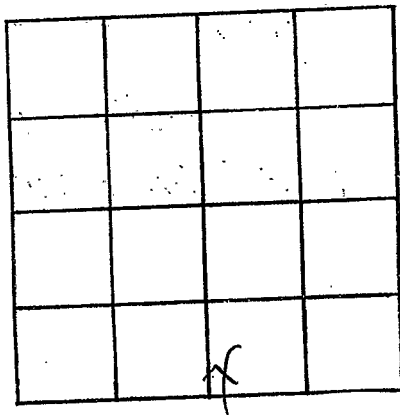

SECTION 24

Please indicate well location X.

ADDITIONAL INFORMATION

If more than one screen, show locations of each on sketch.