

WALTHALL  
C 76  
12-11-72

MISSISSIPPI  
BOARD OF WATER COMMISSIONERS  
416 North State Street  
Jackson, Mississippi 39201

CODED

WATER WELL DRILLERS LOG

Dec 11 1972 date well completed  
Chester Keener Walthall firm name  
county well located

LANDOWNER: Albert Henry  
Rt 5  
Tylertown  
(mailing address)

description of formations encountered	from	to
	Red clay	0
Red chert	4	25
Red sand	25	80
Red sand & gravel	80	100

WELL LOCATION:  
sec. 11 T. 3 N. R. 10 E  
9 miles N.W. of Tylertown  
(distance) (direction) (nearest town)

WELL PURPOSE: Farm  
(home, irrigation, municipal, industrial)

- WELL COMPLETION DATA:
- (1) diameter (inches) 4"
  - (2) total depth (feet) 100
  - (3) static water level (feet) 72 below top of ground.
  - (4) casing Plastic bottom (material) (depth)
  - (5) screen 6' 90' (length) (depth to top)  
1/2" Plast (size) (material)
  - (6) pump 1/2 HP - 12 (HP) (yield gpm)  
elect (type power)
  - (7) electric log no (yes or no)
  - (8) how well bottom plugged completely


CODED

DRILLERS REMARKS:  
all well had

MAY 24 1974

If well telescopes please sketch and show depths.

GROUND LEVEL

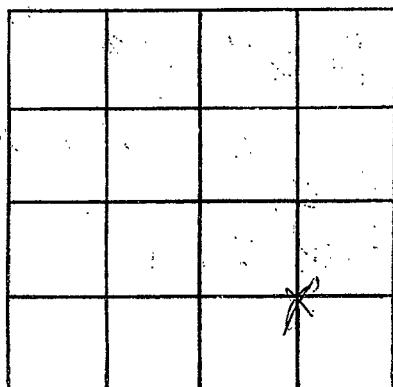

SECTION 11

Please indicate well location X.

ADDITIONAL INFORMATION

If more than one screen,  
show locations of each on sketch.