

**WALTHALL**  
**C-77**  
**6-18-74**

MISSISSIPPI  
 BOARD OF WATER COMMISSIONERS  
 416 North State Street  
 Jackson, Mississippi 39201

WATER WELL DRILLERS LOG

CODED

6-18

19 74 Fitzgerald Well Co

Walthall

date well completed:

firm name:

county well located

LANDOWNER:

Custom Crawford  
RR. Tylahoma, Miss.  
 (mailing address)

description of formations encountered:

from

to

<u>Red clay</u>	<u>0</u>	<u>20</u>
<u>Red gravel</u>	<u>20</u>	<u>95</u>
<u>Red sand</u>	<u>95</u>	<u>130</u>
<u>White chalk</u>	<u>130</u>	<u>210</u>
<u>Coarse sand</u>	<u>210</u>	<u>220</u>

WELL LOCATION:

sec. 31 T. 30 N. R. 10 E.  
8 miles W of Tylahoma  
 (distance) (direction) (nearest town)

WELL PURPOSE:

(home, irrigation, municipal, industrial):

CODED

WELL COMPLETION DATA:


- (1) diameter (inches): 4
- (2) total depth (feet): 220
- (3) static water level (feet): 140 below top of ground.
- (4) casing: Plastic, 2 1/2 (material) (depth)  
4 (size) if telescope see back.
- (5) screen: 8, 212 (length) (depth to top)  
4 (size) Plastic (material)
- (6) pump: 3/4, 10 (HP) (yield gpm)  
Elc (type power)
- (7) electric log no (yes or no)  
 (organization running log)
- (8) how well bottom plugged Sealed

RECEIVED  
 JUL 10 1974

DRILLERS REMARKS:

If well telescopes please sketch and show depths.

GROUND LEVEL

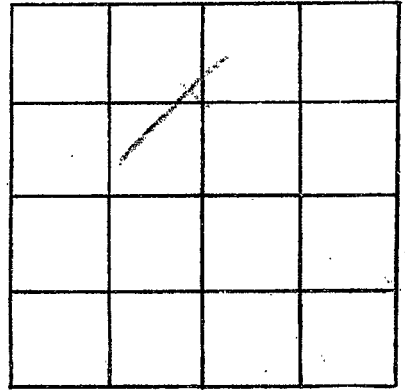

SECTION 31

Please indicate well location X.

ADDITIONAL INFORMATION

If more than one screen,  
show locations of each on sketch.