


WALTHALL  
 C 79  
 8-14-74

MISSISSIPPI  
 BOARD OF WATER COMMISSIONERS  
 416 North State Street  
 Jackson, Mississippi 39201

CODED


WATER WELL DRILLERS LOG

8-14 1974 date well completed  
 F. J. Smith & Son firm name  
 Walthall county well located

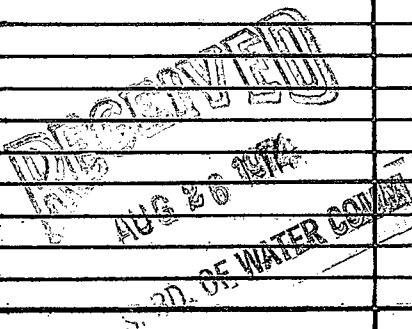LANDOWNER:	description of formations encountered	from	to
Limmie W. Straus III R.R. 1 (mailing address)	Red clay Red sand Coarse sand	0 20 70	20 120 180
WELL LOCATION: sec. 6 T. 30N R. 10E 5 miles S of Egan (distance) (direction) (nearest town)			
WELL PURPOSE: (home, irrigation, municipal, industrial)			
WELL COMPLETION DATA:			
(1) diameter (inches) 4			
(2) total depth (feet) 180			
(3) static water level (feet) 70 below top of ground.			
(4) casing (material) (depth) 182 4 (size) if telescope see back.			
(5) screen (length) (depth to top) 8 172 4 (size) (material)			
(6) pump (HP) (yield gpm) 1/2 10 6HP (type power)			
(7) electric log (yes or no) no			
(organization running log)			
(8) how well bottom plugged Seal block			
DRILLERS REMARKS:			

If well telescopes please sketch and show depths.

GROUND LEVEL

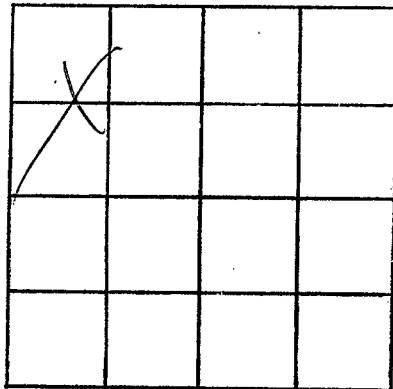

SECTION 6

Please indicate well location X.

ADDITIONAL INFORMATION

If more than one screen,  
show locations of each on sketch.