

MISSISSIPPI  
BOARD OF WATER COMMISSIONERS  
416 North State Street  
Jackson, Mississippi 39201

CODED

WATER WELL DRILLERS LOG

WALTHALL  
C 80  
7-17-74

7-17 date well completed 1974 firm name Fitzgerald Electric county well located Walthall

LANDOWNER:

Goette Macum  
RR. Tylton Miss.  
(mailing address)

description of formations encountered

from to

<u>Red Clay</u>	<u>0</u>	<u>20</u>
<u>Red Sand</u>	<u>20</u>	<u>100</u>
<u>Coarse sand &amp; gravel</u>	<u>100</u>	<u>135</u>

WELL LOCATION:

sec. 31 T. 3 N. R. 10 E.  
8 miles W of Tylton  
(distance) (direction) (nearest town)

WELL PURPOSE:

(home, irrigation, municipal, industrial) Home

WELL COMPLETION DATA:


- (1) diameter (inches) 4
- (2) total depth (feet) 135
- (3) static water level (feet) 105 below top of ground.
- (4) casing Plastic, 127,  
(material) (depth)  
4 if telescope see back.  
(size)
- (5) screen 8, 127  
(length) (depth to top)  
4, Plastic  
(size) (material)
- (6) pump 1/2, 10  
(HP) (yield gpm)  
alt  
(type power)
- (7) electric log Y  
(yes or no)  
(organization running log)
- (8) how well bottom plugged Sand shak

DRILLERS REMARKS:

RECEIVED  
AUG 26 1974  
MISS. BOARD OF WATER COMMISSIONERS

If well telescopes please sketch and show depths.

GROUND LEVEL

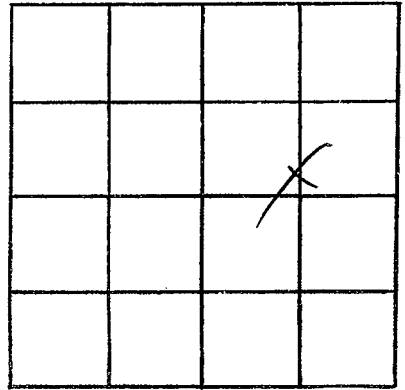

SECTION 31

Please indicate well location X.

ADDITIONAL INFORMATION

If more than one screen,  
show locations of each on sketch.