

WALTHALL  
C 81  
12-14-74

MISSISSIPPI  
BOARD OF WATER COMMISSIONERS  
416 North State Street  
Jackson, Mississippi 39201  
WATER WELL DRILLERS LOG

CODED

RH Desi 1974 J.T. Cunningham Walthall  
date well completed firm name county well located

LANDOWNER:	description of formations encountered	from	to
Isom Dillon			
Lytleton (mailing address)	clay Red bedded sand	25 60	75 102
WELL LOCATION:			
sec. 2 T. 3 (N) R. 10 (E) 6 miles N of Lytleton (distance) (direction) (nearest town)			
WELL PURPOSE: (home, irrigation, municipal, industrial)			
WELL COMPLETION DATA:			
(1) diameter (inches) 4			
(2) total depth (feet) 102			
(3) static water level (feet) 75 below top of ground.			
(4) casing 21 (material), 96 (depth)			
(size) If telescope see back.			
(5) screen 6 (length), 96 (depth to top)			
4 (size), 21 (material)			
(6) pump 1/2 (HP), 8 (yield gpm)			
chx (type power)			
(7) electric log (yes or no)			
(organization running log)			
(8) how well bottom plugged wood			
DRILLERS REMARKS:			


CODED

RECEIVED  
JAN 28 1975

MISS. BD. OF WATER COMM.

If well telescopes please sketch and show depths.

GROUND LEVEL

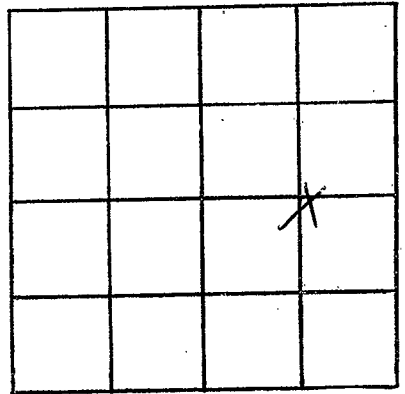

SECTION 2

Please indicate well location X.

ADDITIONAL INFORMATION

If more than one screen, show locations of each on sketch.