

WALTHALL
C 82
1-25-75

MISSISSIPPI
BOARD OF WATER COMMISSIONERS
416 North State Street
Jackson, Mississippi 39201

CODED

WATER WELL DRILLERS LOG

Jan 25 1975 Chet's Pump Walthall
date well completed firm name county well located

LANDOWNER:
Willis Rushing Jr.
Rt. Tipton
(mailing address)

WELL LOCATION:
sec. 11 T 3 N R 10 E
1.0 miles north of Tipton
(distance) (direction) (nearest town)


WELL PURPOSE: home
(home, irrigation, municipal, industrial)

- WELL COMPLETION DATA:
- (1) diameter (inches) 4"
 - (2) total depth (feet) 135
 - (3) static water level (feet) 70 below top of ground.
 - (4) casing plastic, 129 (material) (depth)
 - (size) if telescope see back.
 - (5) screen 6, 129 (length) (depth to top)
 - 4", plastic (size) (material)
 - (6) pump 1, 10 (HP) (yield gpm)
 - elect (type power)
 - (7) electric log no (yes or no)
 - (organization running log)
 - (8) how well bottom plugged wooden plug

description of formations encountered	depth	
	from	to
<u>Red Clay</u>	<u>0</u>	<u>25</u>
<u>Red sand clay</u>	<u>25</u>	<u>90</u>
<u>sand & gravel</u>	<u>90</u>	<u>98</u>
<u>sand & gravel mixed</u>		
<u>Chalk</u>	<u>98</u>	<u>126</u>
<u>sand & gravel</u>	<u>126</u>	<u>135</u>


CODED

DRILLERS REMARKS:
new location

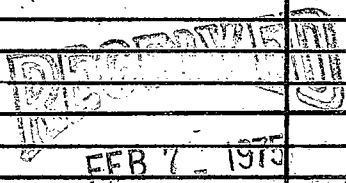

If well telescopes please sketch and show depths.

GROUND LEVEL

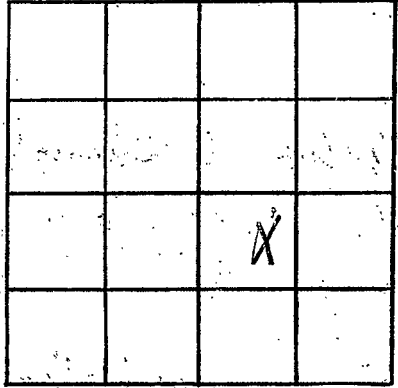

SECTION 11

Please indicate well location X.

ADDITIONAL INFORMATION

If more than one screen, show locations of each on sketch.