

Claude H. Hester

WALTHALL
C 89
10-1-74

MISSISSIPPI
BOARD OF WATER COMMISSIONERS CODED
416 North State Street
Jackson, Mississippi 39201

WATER WELL DRILLERS LOG

Oct 1 1974 ~~Walthall~~ ^{Chapman} Rennie Walthall
date well completed firm name county well located

LANDOWNER: Delasker
Jane
RFD - Tylertown
(mailing address)

description of formations encountered	from	to
clay	0	16
Red sand	16	52
Sand & gravel	52	68
Slightly	68	101
RECOVERED	101	144
Sand hole	144	145
fine sand	145	160
Medium coarse sand	160	178

WELL LOCATION:
sec. 32 T. 3 N R. 10 E
6 miles W. NW of Upton
(distance) (direction) (nearest town)

WELL PURPOSE: house
(home, irrigation, municipal, industrial)

- WELL COMPLETION DATA:
- (1) diameter (inches) 4"
 - (2) total depth (feet) 178
 - (3) static water level (feet) 90 below top of ground.
 - (4) casing plast. bottom (material) (depth)
 - (5) screen 6' (length) 178 (depth to top)
4" (size) plast (material)
 - (6) pump hyolbas (HP) (yield gpm)
(type power)
 - (7) electric log no (yes or no)
(organization running log)
 - (8) how well bottom plugged wooden plug


DRILLERS REMARKS:
new house

RECEIVED
FEB 26 1975

MISS. BLD. OF WATER COMMISSIONERS

If well telescopes please sketch and show depths.

GROUND LEVEL

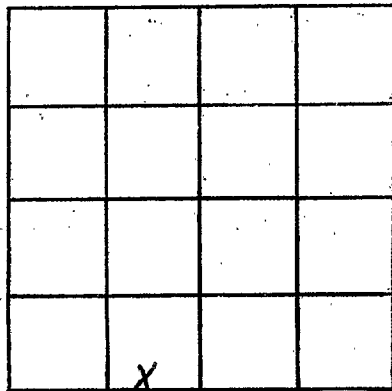

SECTION 32

Please indicate well location X.

ADDITIONAL INFORMATION

If more than one screen, show locations of each on sketch.