

Claude Holmes job

WALTHALL
C 85
10-2-79

MISSISSIPPI
BOARD OF WATER COMMISSIONERS
416 North State Street
Jackson, Mississippi 39201

CODED

WATER WELL DRILLERS LOG

Oct 2 1979 date well completed
Chester Reemes firm name
Walthall county well located

LANDOWNER: Rubie Peters
RFD, Tylertown
(mailing address)

WELL LOCATION:
sec 3 T 3 N R 10 E
6 miles W-NW of Tylertown
(distance) (direction) (nearest town)

WELL PURPOSE: Home
(home, irrigation, municipal, industrial)

- WELL COMPLETION DATA:
- (1) diameter (inches) 4"
 - (2) total depth (feet) 145
 - (3) static water level (feet) 100 below above top of ground.
 - (4) casing Black Galv (material) 145 (depth)
If telescope see back. (size)
 - (5) screen 6" (length) 139 (depth to top)
4" (size) Black (material)
 - (6) pump Brothers (HP) (yield gpm)
(type power)
 - (7) electric log no (yes or no)
(organization running log)
 - (8) how well bottom plugged wood plug

description of formations encountered	from	to
Clay	0	20
Red sand & gravel	20	98
Smith Chalk	98	106
Chalk	106	132
Sand & gravel	132	145

DRILLERS REMARKS: new house


MISS. BD. OF WATER COMM.

FEB 26 1979

REGISTERED

If well telescopes please sketch and show depths.

GROUND LEVEL

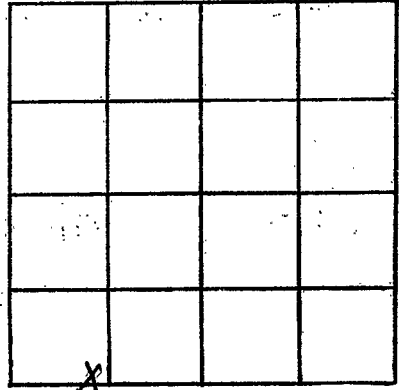

SECTION 32

Please indicate well location X.

ADDITIONAL INFORMATION

If more than one screen, show locations of each on sketch.