

C 86
 Walthall
 3/1/75

MISSISSIPPI
 BOARD OF WATER COMMISSIONERS
 416 North State Street
 Jackson, Mississippi 39201

CODED
 Walthall
 Felt

WATER WELL DRILLERS LOG

1/1/75 date well completed 25 J.T. Conyers firm name Walthall county well located

LANDOWNER: Highline Photo
 Prudal (mailing address)

description of formations encountered: clay, chert, sand, chalk, sand

from	to
0	25
25	65
67	85
85	135

WELL LOCATION:
 sec. 1 T. 3 N. R. 9 E
 4 miles SE Prudal (distance) (direction) (nearest town)

WELL PURPOSE:
 (home, irrigation, municipal, industrial)


- WELL COMPLETION DATA:
- (1) diameter (inches) 4
 - (2) total depth (feet) 135
 - (3) static water level (feet) 85 below top of ground.
 - (4) casing (material) PL, (depth) 129
 - (size) If telescope see back.
 - (5) screen (length) 6, (depth to top) 129
 - (size) 4, (material) PL
 - (6) pump (HP) 1/2, (yield gpm) 8
 - (type power) elect
 - (7) electric log (yes or no)
 - (organization running log)
 - (8) how well bottom plugged wood

RECEIVED
 JUN 6 1975

DRILLERS REMARKS:

If well telescopes please sketch and show depths.

GROUND LEVEL

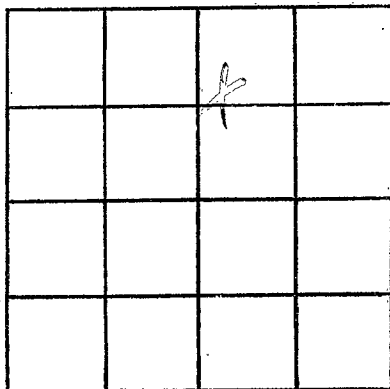

SECTION 1

Please indicate well location X.

ADDITIONAL INFORMATION

If more than one screen, show locations of each on sketch.