

Walthall  
 C 88  
 5-12-75

MISSISSIPPI  
 BOARD OF WATER COMMISSIONERS  
 416 North State Street  
 Jackson, Mississippi 39201

CODED

WATER WELL DRILLERS LOG

12 May 1975  
 date well completed

J. T. Conroy & Co.  
 firm name

Walthall  
 county well located

LANDOWNER:  
 Wesley Harvey  
 Tylata  
 (mailing address)

description of formations encountered	from	to
clay	0	25
red chert	25	45
clay	45	60
sand	50	74

WELL LOCATION:  
 sec 26 T 3 N R 10 E 134  
 4 miles N of Tylata  
 (distance) (direction) (nearest town)

WELL PURPOSE:  
 (home, irrigation, municipal, industrial)

WELL COMPLETION DATA:

(1) diameter (inches) 4

(2) total depth (feet) 74

(3) static water level (feet) 68 below above top of ground.

(4) casing P1 68 (material) (depth)  
 (size) if telescope see back.

(5) screen 6 68 (length) (depth to top)  
 4 P1 (size) (material)

(6) pump 1/2 8 (HP) (yield gpm)  
 direct (type power)

(7) electric log (yes or no)

(organization running log)


(8) how well bottom plugged wood

DRILLERS REMARKS:

MISSISSIPPI  
 AUG 7 1975

If well telescopes please sketch and show depths.

GROUND LEVEL

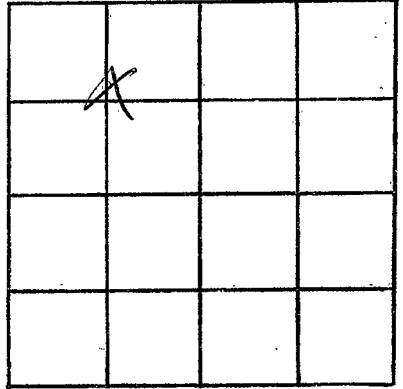

SECTION 26

Please indicate well location X.

ADDITIONAL INFORMATION

If more than one screen,  
show locations of each on sketch.