

Walshall
C 89
6-28-75

MISSISSIPPI
BOARD OF WATER COMMISSIONERS
416 North State Street
Jackson, Mississippi 39201

CODED
Walshall

WATER WELL DRILLERS LOG

June 28 1975 *Beams Well Drilling*
date well completed firm name county well located

LANDOWNER:	description of formations encountered	from	to
<i>John Whittington</i> <i>Box 2 McComb Miss</i> (mailing address)			

WELL LOCATION:
sec 25 T 3 N R 9 E ¹³⁰
3 miles east of Hornville
(distance) (direction) (nearest town)

WELL PURPOSE: Camp
(home, irrigation, municipal, industrial)

- WELL COMPLETION DATA:
- (1) diameter (inches) 4"
 - (2) total depth (feet) 100'
 - (3) static water level (feet) 36 above top of ground
 - (4) casing plastic bottom
(material) (depth)
 - If telescope see back.
(size)
 - (5) screen 6" 91'
(length) (depth to top)
 - 4" plastic
(size) (material)
 - (6) pump split 6
(HP) (yield gpm)
 - elect
(type power)
 - (7) electric log no
(yes or no)
 - (organization running log)


(8) how well bottom plugged wooden plug

DRILLERS REMARKS:

RECEIVED
SEP - 6 1975

If well telescopes please sketch and show depths.

GROUND LEVEL

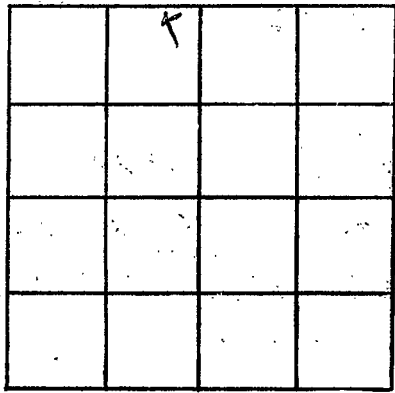

SECTION 25

Please indicate well location X.

ADDITIONAL INFORMATION

Lined area for additional information.

If more than one screen, show locations of each on sketch.