

Walthall
 C 90
 7-25-75

MISSISSIPPI
 BOARD OF WATER COMMISSIONERS
 416 North State Street
 Jackson, Mississippi 39201

WATER WELL DRILLERS LOG

CODED

July 25 1975 *Reems Well Drilling* *Walthall*
 date well completed firm name county well located

LANDOWNER:
kinsia Mae Peters
Rt 2 Tylertown
 (mailing address)

description of formations encountered	from	to
<i>Red Clay</i>	<i>0</i>	<i>23</i>
<i>Red sand & gravel</i>	<i>23</i>	<i>70</i>
<i>Hard white Chalk</i>	<i>70</i>	<i>144</i>
<i>Coarse sand & peagum</i>	<i>144</i>	<i>165</i>

WELL LOCATION:
 sec. *32* T. *3* N. R. *10* E
6 miles *W. N.W.* of *Tylertown*
 (distance) (direction) (nearest town)

WELL PURPOSE: *Home*
 (home, irrigation, municipal, industrial)

- WELL COMPLETION DATA:
- (1) diameter (inches) *4"*
 - (2) total depth (feet) *165*
 - (3) static water level (feet) *70* below top of ground.
 - (4) casing *plastic bottom*
 (material) (depth)
 - (5) screen *6'* *159*
 (length) (depth to top)
 - 4"* *plastic*
 (size) (material)
 - (6) pump *1/2 Sub* *10*
 (HP) (yield gpm)
 - elect*
 (type power)
 - (7) electric log *no*
 (yes or no)


(8) how well bottom plugged
wooder plug

DRILLERS REMARKS:
old well went dry

RECEIVED
 OCT - 6 1975

If well telescopes please sketch and show depths.

GROUND LEVEL

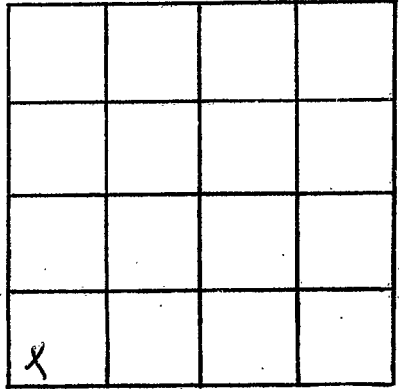

SECTION 32

Please indicate well location X.

ADDITIONAL INFORMATION

If more than one screen, show locations of each on sketch.