

MISSISSIPPI DEPARTMENT OF NATURAL RESOURCES

Bureau of Land and Water Resources

Southport Mall

P.O. Box 10631

Jackson, Mississippi 39209

WATER WELL DRILLERS LOG **CODED**

WALTHALL
CU
9-18-85

9-18 1985 Fitzgerald well serv Walthall
date well completed firm name county well located

LANDOWNER:
Larry Smith
101, Jones, ms.
(mailing address)

description of formations encountered	from	to
<u>Red clay</u>	<u>0</u>	<u>20</u>
<u>Sand & gravel</u>	<u>20</u>	<u>90</u>
<u>Red sand</u>	<u>90</u>	<u>130</u>
<u>Coarse sand & gravel</u>	<u>130</u>	<u>160</u>

WELL LOCATION:
sec. 4 T. 3 (N) S R. 10 (E) W
8 miles N of Flytown
(distance) (direction) (nearest town)

WELL PURPOSE: IRR - POND
(home, irrigation, municipal, industrial)

WELL COMPLETION DATA:

(1) diameter (inches) 4

(2) total depth (feet) 160

(3) static water level (feet) 30 below above top of ground.

(4) casing PVC, 130,
(material) (depth)
4 if telescope see back.
(size)

(5) screen 30, 130
(length) (depth to top)
4, PVC
(size) (material)

(6) pump air, 150
(HP) (yield gpm)
Diesel
(type power)

(7) electric log no
(yes or no)
(organization running log)

(8) how well bottom plugged Sand like

CODED

RECEIVED


NOV - 5 1985

Department of Natural Resources
Bureau of Land & Water Resources

DRILLERS REMARKS: _____

If well telescopes please sketch and show depths.

GROUND LEVEL

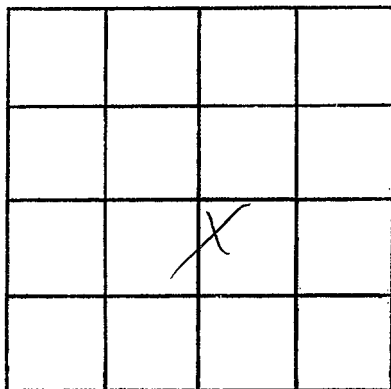

SECTION 4

Please indicate well location X.

ADDITIONAL INFORMATION

If more than one screen,
show locations of each on sketch.