

MISSISSIPPI DEPARTMENT OF NATURAL RESOURCES

Bureau of Land and Water Resources

Southport Mall

CODED

P.O. Box 10631

Jackson, Mississippi 39209

WATER WELL DRILLERS LOG

8-12
date well completed1987 River City Well Well
firm nameWalthall
county well located

LANDOWNER:

Ernest Dudley

413 Lital Rd

Natchez Ms.

(mailing address)

WELL LOCATION:

sec. 3 T 3 N R 10 E

10 miles North of Tyler town
(distance) (direction) (nearest town)

WELL PURPOSE:

Oil Supply

(home, irrigation, municipal, industrial)

WELL COMPLETION DATA:

- (1) diameter (inches) 3"
- (2) total depth (feet) 135'
- (3) static water level (feet) 60 below
top of ground above
- (4) casing PUC 115'
(material) (depth)
3" if telescope see back.
(size)
- (5) screen 20' 115'
(length) (depth to top)
3" PUC
(size) (material)
- (6) pump 50
(HP) (yield gpm)
Air Injection
(type power)
- (7) electric log No
(yes or no)

(organization running log)

(8) how well bottom plugged

Backwash
Jala - packed

DRILLERS REMARKS:

description of formations
encountered

from

to

Red Clay	0	20
Gravel & Sand	20	40
White Chalk	40	60
Sand Fine	60	80
Fine & Coarse	80	110
Gravel	110	120
Coarse sand	120	140
Small Rock & Sand	130	135


RECEIVED

AUG 13 1987

Department of Natural Resources
Bureau of Land & Water Resources

If well telescopes please
sketch and show depths.

GROUND LEVEL

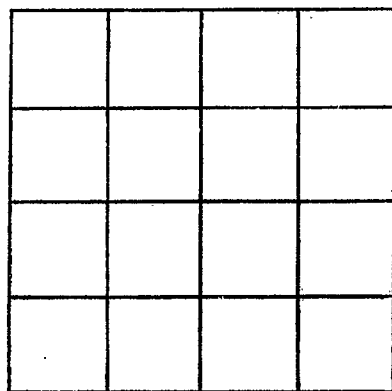

SECTION _____

Please indicate well location X.

ADDITIONAL INFORMATION

If more than one screen,
show locations of each on sketch.