

WALTHAM
 C-100
 9-21-80

MISSISSIPPI
 BOARD OF WATER COMMISSIONERS CODED
 416 North State Street
 Jackson, Mississippi 39201

WATER WELL DRILLERS LOG

Sept-21 1980 *News-Market* *Waltham*
 date well completed firm name county well located

LANDOWNER:
Larry Hughes
Rt 3 - Tylertown
 (mailing address)

description of formations encountered	from	to
<i>Clay</i>	<i>0</i>	<i>5</i>
<i>Red sand</i>	<i>5</i>	<i>18</i>
<i>Red chalk</i>	<i>18</i>	<i>35</i>
<i>sand</i>	<i>35</i>	<i>60</i>
<i>sand & pea gravel</i>	<i>60</i>	<i>82</i>

WELL LOCATION:
 sec *2* T *3* N R *10* E
10 miles *north* of *Tylertown*
 (distance) (direction) (nearest town)

WELL PURPOSE: *home*
 (home, irrigation, municipal, industrial)

CODED

WELL COMPLETION DATA:
 (1) diameter (inches) *4"*
 (2) total depth (feet) *82'*
 (3) static water level (feet) *64'* below top of ground.
 (4) casing *plastic*, *bottom*
 (material) (depth)
 (5) screen *5'*, *77'*
 (length) (depth to top)
4", *plastic*
 (size) (material)
 (6) pump *1/2 hp*, *10*
 (HP) (yield gpm)
electric
 (type power)
 (7) electric log *no*
 (yes or no)
 (organization running log)

(8) how well bottom plugged
wooden plug

DRILLERS REMARKS:


DEPT. OF NATURAL RESOURCES
 BUREAU OF LAND & WATER RESOURCES

SEP 2 - 1980

RECEIVED

If well telescopes please sketch and show depths.

GROUND LEVEL

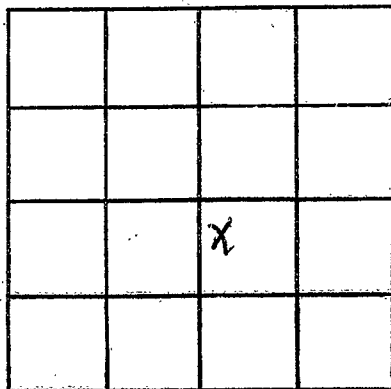

SECTION 2

Please indicate well location X.

ADDITIONAL INFORMATION

If more than one screen, show locations of each on sketch.