

MISSISSIPPI DEPARTMENT OF NATURAL RESOURCES

Bureau of Land and Water Resources

Southport Mall

P.O. Box 10631

Jackson, Mississippi 39209

**CODED**

WATER WELL DRILLERS LOG

WALTHALL  
C101  
1-7-82

Griner Drilling Service, INC.

Walthall

1-7-82 date well completed

Griner Drilling Service, INC. firm name

Walthall county well located

LANDOWNER:	description of formations encountered	from	to
(mailing address)			
Cockrell Oil Corp. Suite 999 Main Bldg. Houston, Texas 77002	Chalk, clay, gravel	0	42
WELL LOCATION: 1500'S & 1500' W sq. 4 T-30 R-10 NE COR DINON Field	Sand, pea gravel	42	378
WELL PURPOSE: oil field (home, irrigation, supply, industrial)	chalk	378	399
<b>WELL COMPLETION DATA:</b>			
(1) diameter (inches) 4"			
(2) total depth (feet) 399'			
(3) static water level (feet) 70' <u>below</u> top of ground.			
(4) casing <u>steel</u> 378' (material) (depth)			
4" if telescope see back. (size)			
(5) screen 42' 336' (length) (depth to top)			
4" perforated (size) (material)			
(6) pump - 85-90 (HP) (yield gpm)			
AC (type power)			
(7) electric log - (yes or no)			
(organization running log)			
(8) how well bottom plugged <u>orange peel</u>			

**CODED**

DEPT. OF NATURAL RESOURCES  
BUREAU OF LAND & WATER RESOURCES


JAN 21 1982

RECEIVED

DRILLERS REMARKS:

If well telescopes please sketch and show depths.

GROUND LEVEL

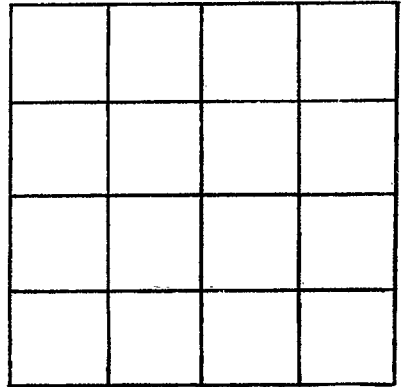

SECTION \_\_\_\_\_

Please indicate well location X.

ADDITIONAL INFORMATION

If more than one screen,  
show locations of each on sketch.