

MISSISSIPPI DEPARTMENT OF NATURAL RESOURCES

Bureau of Land and Water Resources

Southport Mall

P.O. Box 10631

Jackson, Mississippi 39209

WATER WELL DRILLERS LOG

CODED

WALTHALL
C 102
1/83
Elog # 74

date well completed 19 83 GRINER DRILLING SER. WALTHALL firm name county well located

LANDOWNER:

TRANSCONTINENTAL PIPELINE

CORP. - THERTOWN, MS.

Well No. 2R (mailing address)

WELL LOCATION:

sec. 9 T. 3 N. R. 10 E. S. 5 W.

10 miles NORTH of THERTOWN
(distance) (direction) (nearest town)

WELL PURPOSE:

(home, irrigation, municipal, industrial)

WELL COMPLETION DATA:

(1) diameter (inches) 12 3/4
(2) total depth (feet) 392

(3) static water level (feet) 97.42 below above top of ground.

(4) casing steel, 352 ft.
(material) (depth)

12 3/4"
(size) if telescope see back.

(5) screen 30, 362 ft.
(length) (depth to top)

8", 304 SS. 60/6
(size) (material)

(6) pump 25, 310
(HP) (yield gpm)

ELECT.
(type power)

(7) electric log YES
(yes or no)

MISS GEO. SURVEY
(organization running log)

(8) how well bottom plugged BACK
WASH VALVE

description of formations encountered

from

to

Top Soil

0 2

SAND

2 96

SAND

96 117

CLAY + SAND

117 139

SAND + GRAVEL

139 158

SAND

158 179

SAND + GRAVEL, COARSE

179 263

GRAVEL

263 284

CLAY

284 326

SAND

326 347

SAND + pea Gravel

347 389

CLAY

389 392

CODED

DEPT. OF NATURAL RESOURCES
BUREAU OF LAND & WATER RESOURCES

JAN 31 1983


RECEIVED

DRILLERS REMARKS:

12

If well telescopes please sketch and show depths.

GROUND LEVEL

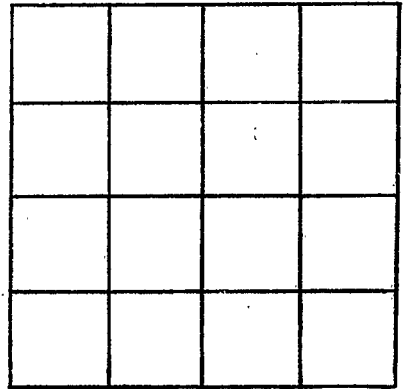

SECTION _____

Please indicate well location X.

ADDITIONAL INFORMATION

If more than one screen,
show locations of each on sketch.