

MISSISSIPPI DEPARTMENT OF NATURAL RESOURCES

Bureau of Land and Water Resources

Southport Mall

P.O. Box 10631

CODED

Jackson, Mississippi 39209

WATER WELL DRILLERS LOG

C103
 WARTHALL
 5-10-84

5-10
 date well completed

1984 *Flycatcher Well Serv*
 firm name

Walthall
 county well located

LANDOWNER:	description of formations encountered	from	to
<i>Sony Smith</i>	<i>Red Clay</i>	0	20
<i>Ms. Flycatcher, Inc. (mailing address)</i>	<i>Red Sand</i>	20	85
	<i>Coarse Sandstone</i>	85	100
<p>WELL LOCATION:</p> <p>sec. <u>6</u> T <u>3</u> (N) R <u>10</u> (E)</p> <p><u>9</u> miles <u>HW</u> of <u>Flycatcher</u></p> <p>(distance) (direction) (nearest town)</p>			
<p>WELL PURPOSE: <u>Home</u></p> <p>(home, irrigation, municipal, industrial)</p>			
<p>WELL COMPLETION DATA:</p> <p>(1) diameter (inches) <u>4</u></p> <p>(2) total depth (feet) <u>100</u></p> <p>(3) static water level (feet) <u>35</u> below above top of ground.</p> <p>(4) casing <u>PVC</u>, <u>92</u>, (material) (depth), <u>4</u> (size) if telescope see back.</p> <p>(5) screen <u>8</u>, <u>92</u> (length) (depth to top) <u>4</u>, <u>PVC</u> (size) (material)</p> <p>(6) pump <u>1/2</u>, <u>16</u> (HP) (yield gpm) <u>Electric</u> (type power)</p> <p>(7) electric log <u>No</u> (yes or no) (organization running log)</p> <p>(8) how well bottom plugged <u>Sand shell</u></p>			

DEPT. OF NATURAL RESOURCES
 BUREAU OF LAND & WATER RESOURCES


JUN 15 1984

RECEIVED

DRILLERS REMARKS:

If well telescopes please
sketch and show depths.

GROUND LEVEL

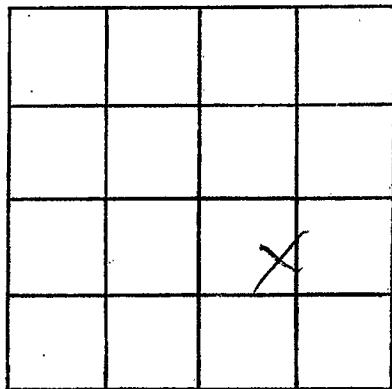

SECTION C

Please indicate well location X.

ADDITIONAL INFORMATION

If more than one screen,
show locations of each on sketch.