

MISSISSIPPI DEPARTMENT OF NATURAL RESOURCES

Bureau of Land and Water Resources

Southport Mall

P.O. Box 10631

Jackson, Mississippi 39209

WATER WELL DRILLERS LOG

WALTHALL
C 105
4-19-85

4-19 19 85 Walthall Walthall
date well completed firm name county well located

LANDOWNER:	description of formations encountered	from	to
<u>James A. Mager</u> <u>P.R. 3 Tylton</u> (mailing address)	<u>Red clay</u>	<u>0</u>	<u>20</u>
	<u>Red Sand</u>	<u>20</u>	<u>60</u>
	<u>white chalk</u>	<u>60</u>	<u>165</u>
	<u>Coarse sand & gravel</u>	<u>165</u>	<u>179</u>
WELL LOCATION: sec. <u>36</u> T. <u>3</u> (N) R. <u>10</u> (E) <u>8</u> miles <u>W</u> of <u>Tylton</u> (distance) (direction) (nearest town)			
WELL PURPOSE: <u>H</u> (home, irrigation, municipal, industrial)			
WELL COMPLETION DATA:			
(1) diameter (inches) <u>4</u>			
(2) total depth (feet) <u>179</u>			
(3) static water level (feet) <u>100</u> below above top of ground.			
(4) casing <u>PVC</u> , <u>169</u> (material) (depth) <u>4</u> if telescope see back. (size)			
(5) screen <u>10</u> , <u>169</u> (length) (depth to top) <u>4</u> (size), <u>PVC</u> (material)			
(6) pump <u>1/2</u> , <u>10</u> (HP) (yield gpm) <u>Electric</u> (type power)			
(7) electric log <u>no</u> (yes or no) <u>Walthall</u> (organization running log)			
(8) how well bottom plugged <u>Sealed</u>			

RECEIVED


MAY 17 1985

DRILLERS REMARKS:

Department of Natural Resources
Bureau of Land & Water Resources

If well telescopes please sketch and show depths.

GROUND LEVEL

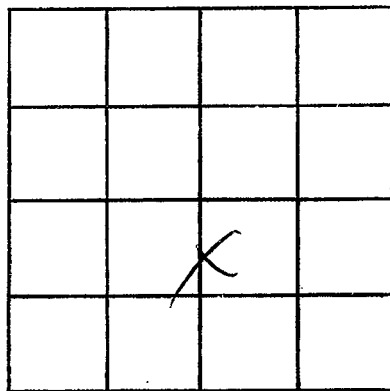

SECTION 36

Please indicate well location X.

ADDITIONAL INFORMATION

If more than one screen,
show locations of each on sketch.