

WALTHALL
 C 106
 4-22-85

MISSISSIPPI DEPARTMENT OF NATURAL RESOURCES
 Bureau of Land and Water Resources
 Southport Mall
 P.O. Box 10631
 Jackson, Mississippi 39209
WATER WELL DRILLERS LOG

4-22 1985 Fitzgerald well Serv Walthall
 date well completed firm name county well located

LANDOWNER:
Cecilia Smith
P.B. Fitzhugh, Jr.
 (mailing address)

description of formations encountered	from	to
<u>Red Clay</u>	<u>0</u>	<u>20</u>
<u>Red sand</u>	<u>20</u>	<u>135</u>
<u>Coarse sand & gravel</u>	<u>135</u>	<u>150</u>

WELL LOCATION:
 sec. 32 T. 3 (N) S R. 10 (E) W
6 miles W of Ft. Lenoir
 (distance) (direction) (nearest town)

WELL PURPOSE: Home
 (home, irrigation, municipal, industrial)

- WELL COMPLETION DATA:
- (1) diameter (inches) 4
 - (2) total depth (feet) 150
 - (3) static water level (feet) 100 below above top of ground.
 - (4) casing PVC, 140,
 (material) (depth)
4 if telescope see back.
 (size)
 - (5) screen 10, 140
 (length) (depth to top)
4, PVC
 (size) (material)
 - (6) pump 1/2 10
 (HP) (yield gpm)
Electric
 (type power)
 - (7) electric log no
 (yes or no)
 (organization running log)
 - (8) how well bottom plugged sealed

RECEIVED


MAY 17 1985

DRILLERS REMARKS:

Department of Natural Resources
 Bureau of Land & Water Resources

If well telescopes please sketch and show depths.

GROUND LEVEL

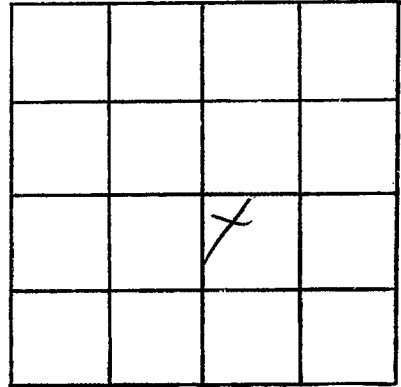

SECTION 32

Please indicate well location X.

ADDITIONAL INFORMATION

If more than one screen,
show locations of each on sketch.