

MISSISSIPPI DEPARTMENT OF ENVIRONMENTAL QUALITY

Office of Land and Water Resources

P. O. Box 10631
Jackson, MS 39289-0631

WATER WELL DRILLERS LOG

COUNTY WELL LOCATED <i>Washington</i>	
WELL NUMBER <i>C-112</i>	CODED
DATE WELL COMPLETED <i>7-16-03</i>	

PERMIT NUMBER
NAME OF DRILLING FIRM <i>Pitseauld Well Services</i>

NAME & MAILING ADDRESS OF LANDOWNER <i>To Magee</i>			
<i>Magee lane Tuxess, MS</i>			
Latitude:			
Longitude:			
WELL LOCATION	SEC <i>10</i>	TOWNSHIP <i>3</i>	RANGE <i>10</i>
		<i>N</i>	<i>W</i>
DISTANCE <i>9</i> Miles	DIRECTION <i>N</i>	NEAREST TOWN <i>Tylerblount</i>	
OTHER LANDMARK			
WELL PURPOSE: Home, Irrigation, Municipal, Industrial, Fish Pond, etc.			

PUMP DATA			
PUMP TYPE (Circle One):			
<input checked="" type="radio"/> Submersible	<input type="radio"/> Turbine	<input type="radio"/> Jet	<input type="radio"/> Flowing Well
Other (Describe)			
POWER TYPE (Circle One):			
<input checked="" type="radio"/> Electric	<input type="radio"/> Tractor	<input type="radio"/> Diesel	<input type="radio"/> Gasoline
Other (Describe)		<i>5</i>	<input type="radio"/> Butane
		H/P	

DESCRIPTION OF FORMATIONS ENCOUNTERED	FROM	TO
<i>clay</i>	<i>0</i>	<i>20</i>
<i>sand & gravel</i>	<i>20</i>	<i>75</i>
<i>clay</i>	<i>75</i>	<i>90</i>
<i>sand</i>	<i>90</i>	<i>100</i>
<i>course sand & gravel</i>	<i>100</i>	<i>120</i>

WELL DATA

Well Depth <i>120</i>	Casing Diameter (In.) <i>4"</i>	Casing Length (Ft.) <i>100'</i>
Type of Casing <i>Pvc</i>	Hole Depth <i>120'</i>	Depth to Static Water Level <i>70'</i>

TYPE OF COMPLETION: (Circle One or More):
 Gravel Packed Underreamed Telescoped
 Natural Development Open Hole Other (Describe)

WELL GROUTED TO A DEPTH OF *10* FEET
 Type Grout (circle one): Cement, Bentonite, or *Mix*

SCREEN DATA

Diameter - Inches <i>4"</i>	Length - Feet <i>20</i>	Slot Size - Inches <i>1/16" x 1/32"</i>
Screen Type <i>Pvc</i>	Depth to Bottom - Feet <i>120'</i>	

RECEIVED

JUL 28 2003

BY: OLWR

Top of Lap Pipe or Reduction in Casing
FEET IF TELESKOPED OR MORE THAN ONE SCREEN: USE BACK PAGE

I certify that the well was drilled, constructed and completed in accordance with all applicable Requirements of the Mississippi Department of Environmental Quality and/or the Mississippi Department of Health regulations and state laws.


Bead Stegwald *029*
Signature of Licensed Driller and License No.

7-16-03
Date

Additional Information Required On Back

If well telescopes please sketch and show depths.

GROUND LEVEL

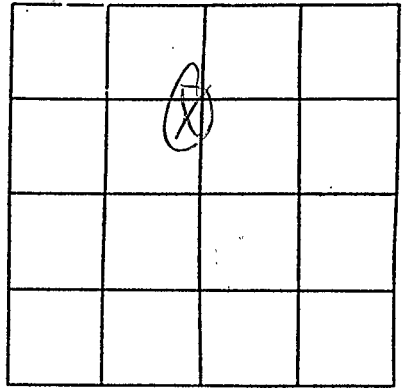

SECTION 10

Please indicate well location X.

Pump Capacity (GPM)	No. of Stages	Setting Depth
85		100' FT.

PUMP TEST

Well yielded _____ GPM with
a drawdown of _____ ft.
after _____ hours of pumping

LOG DATA

TYPE OF LOG RUN (Circle One): No Log Run, Electric, Gamma Ray, Density, Sonic, Neutron, Other (Describe) _____

Name of Organization Running Log

GEOLOGIC DATA (Office Use Only)

Surface Elev.	Geologic Unit	Unit Thickness	Depth to Top
Subs. SWL	Date	Analysis	Aquifer Test

Driller's Remarks

If more than one screen, show location of each on sketch.