

# State Well Report

## Part 1 - Driller's Log

Mississippi Department of Environmental Quality  
Office of Land and Water Resources  
P.O. Box 10631  
Jackson, MS 39289-0631  
(601)961-5210  
(601)354-6938 (fax)

County: Waltham  
Permit #: \_\_\_\_\_  
Driller: Fitzgerald Well Services  
Date drilling completed: 2-20-07

For Office Use Only:  
Aquifer: \_\_\_\_\_  
Well #: C-141  
L. S. Elevation: \_\_\_\_\_  
E-log #: \_\_\_\_\_

State Law requires that this report be prepared by the license holder responsible for the work and filed with the Department at the above address within 30 days of completion of drilling of the well or borehole.

Information on Well Owner (Landowner if borehole is not for a water well)	Well or Borehole Location
Owner Name: <u>Len Herring</u>	Latitude: <u>31.12.34</u> Longitude: <u>90.14.10.2</u>
Mailing Address: <u>Old Helmsville Rd</u>	Method of Lat/Long (circle one): <u>Conventional Survey</u>
<u>Tylerdown</u> MS City State Zip Code	USGS quad, Hand-held GPS, Survey-grade GPS
Telephone No. ( ) _____	<u>1/4</u> <u>1/4</u> Sec <u>19</u> Twn <u>3N</u> Rng <u>10E</u>
	Distance Direction Nearest Town Miles of _____

**Well / Borehole Data**

Date drilling started: 2-20-07. Date drilling completed: 2-20-07. Hole depth: 200' Hole diameter: 7"

Location of the source of any surface water used for drilling: \_\_\_\_\_  
Method of dosing and volume of Chlorine used in drilling and development: \_\_\_\_\_

Logs run (circle all applicable): No log run Electric Gamma Ray Density Sonic Neutron Other: \_\_\_\_\_  
Name of organization running log(s): \_\_\_\_\_

Purpose of borehole (check one): Water Well  Geotechnical/Geological Investigation \_\_\_\_\_ Ground Source Heat Pump \_\_\_\_\_  
Seismic Survey \_\_\_\_\_ Other (describe) \_\_\_\_\_  
*If drilling is not related to water well construction, skip the remainder of this block.*

Purpose of Well (check one): Home  Industrial \_\_\_\_\_ Public Supply \_\_\_\_\_ Irrigation \_\_\_\_\_ Fish Culture \_\_\_\_\_ Other: Bleu Berry Farm

If a flowing well, method of flow regulation: Valve \_\_\_\_\_ Other (describe) \_\_\_\_\_

Static Water Level: 80' feet above or below (circle one) land surface Date measured: 2-20-07

Method of Measurement (circle one) steel tape electric tape air line other: \_\_\_\_\_

Well depth: 200' Well grouted to a depth of 10' feet Type of grout (circle one) Neat Cement Bentonite Mix

Casing length: 180' feet Casing diameter: 4" inches Type of casing: PVC

Screen length: 20' feet Screen diameter: 4 1/2" inches Type of screen: PVC

Screen slot size: 0 10/12 inches Setting depth: From 180' feet to 200' feet

Type of completion (circle all applicable): Gravel packed Underreamed Telescoped Open hole Natural Development  
Other (describe): \_\_\_\_\_


Top of lap pipe or reduction in casing: \_\_\_\_\_ feet. *If telescoped or more than one screen, describe on next page*

Form: OLWR-SWR-1A

RECEIVED  
MAR 05 2007  
BY: OLWR

The sketch below only required for water wells


If well screens, show depth on sketch

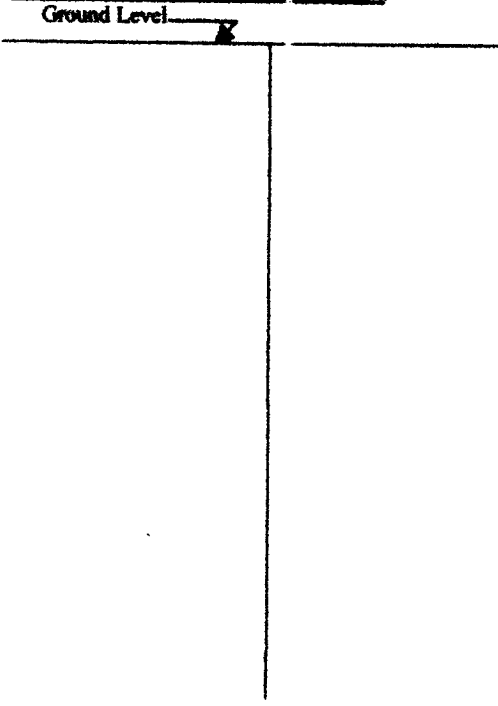

Description of formations encountered must be provided for all wells and boreholes, unless specifically exempted by regulations

Description of Formations Encountered	From (depth)	To (depth)
	Ground Level	
Clay	0	20
gravel	20	60
clay	60	80
Sand	80	120
clay	120	140
Sand	140	180
Coarse Sand	180	200

If more than one screen, show location of each on sketch

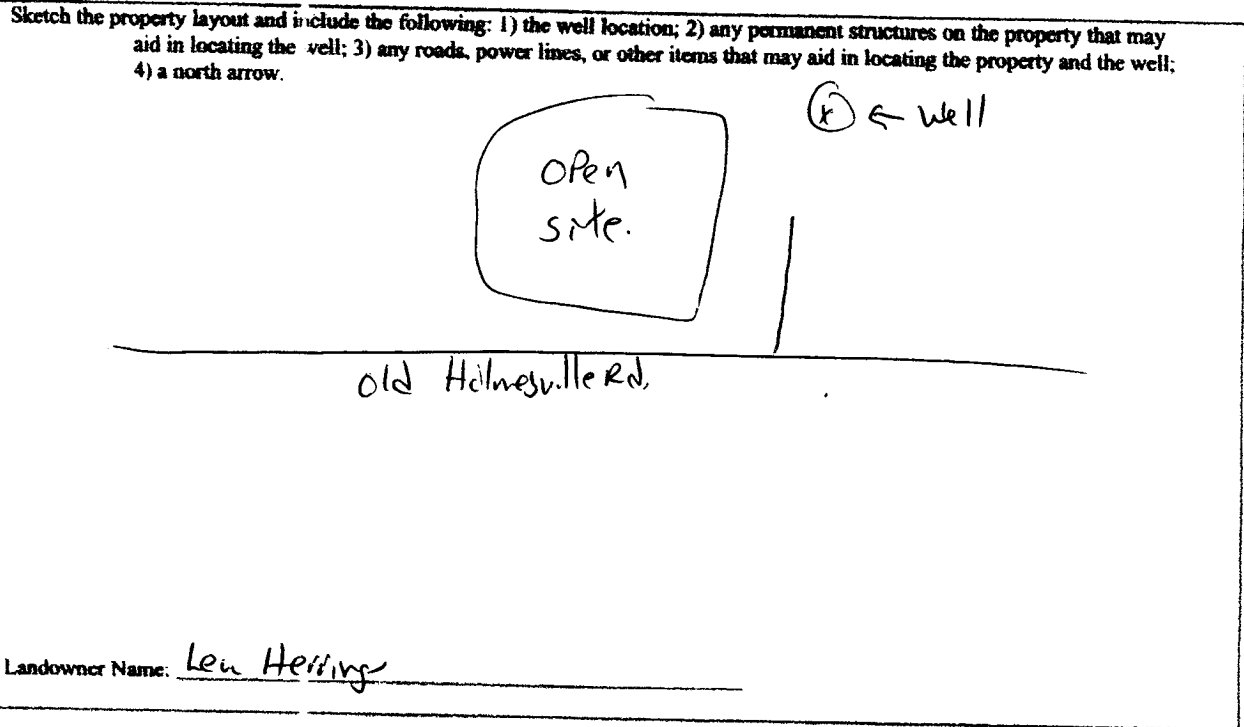

Form: OLWR-SWR-1A

I certify that the well/borehole was drilled, constructed, and completed in accordance with all applicable requirements of the Mississippi Department of Environmental Quality and the Mississippi Department of Health regulations, if applicable, and state laws.

Brad Fitzgerald      029      2-20-07

Brad Fitzgerald

Print Name of Responsible Licensee and License No.

Date

Signature of Licensee

RECEIVED

MAR 05 2007

BY: OLWR

# STATE WELL REPORT

## Part 2

**Pump Installer's Completion Report**  
 Mississippi Department of Environmental Quality  
 Office of Land and Water Resources  
 P.O. Box 10631  
 Jackson, MS 39289-0631  
 (601)961-5210  
 (601)354-6938 (fax)

County: Waltham  
 Permit #: \_\_\_\_\_  
 Driller: Fitzgerald Well Serv  
 Date completed: 2-20-07  
*Copy information from block 1 of Part 1*

For Office Use Only:

Aquifer: \_\_\_\_\_  
 Well #: C-141  
 Elevation: \_\_\_\_\_

*This part of the report must be completed by a licensed water well contractor or a licensed pump installer. A copy of Part 1 of the report must be attached and both parts filed with the Department at the above address within 30 days of well completion.*

Well Owner Information	Well Location
Owner Name: <u>Leu Herring</u>	Latitude: <u>31° 12' 34"</u> Longitude: <u>90° 14' 10.2"</u>
Mailing Address: <u>Old Holmesville Rd</u>	Method of Lat/Long (check one): <input checked="" type="checkbox"/> Conventional Survey
<u>Tylertown</u> <u>MS</u>	USGS quad _____ Hand-held GPS _____ Survey-grade GPS _____
City State Zip Code	<u>1/4</u> <u>1/4</u> Sec <u>19</u> <u>3N R 10E</u>
Telephone No. (_____) _____	Distance _____ Direction _____ Nearest Town _____
	_____ Miles _____ of _____

Pump Type Circle one	Power Type Circle one
Air Lift <input type="checkbox"/> Jet <input type="checkbox"/> <input checked="" type="checkbox"/> <b>Submersible</b>	Diesel Engine <input type="checkbox"/> Gasoline Engine <input type="checkbox"/> Natural Gas <input type="checkbox"/>
Bucket <input type="checkbox"/> Piston <input type="checkbox"/> Turbine <input type="checkbox"/>	<input checked="" type="checkbox"/> <b>Electric Motor</b> <input type="checkbox"/> Hand <input type="checkbox"/> Tractor PTO
Centrifugal <input type="checkbox"/> Rotary <input type="checkbox"/> Flowing Well <input type="checkbox"/>	Windmill <input type="checkbox"/> Other (specify): _____
Other (specify): _____	Horse Power Rating of Motor: <u>5 HP</u>
Date Pump Installed: <u>2-20-07</u>	Setting Depth: <u>140</u> feet
Rated Pump Capacity: <u>80</u> Gallons Per Minute	Number of Stages: <u>?</u>

Pump Test Data	Method of Measuring Water Level Circle one
Date Well Tested: _____	Air Line <input type="checkbox"/> Electric Measuring Line <input checked="" type="checkbox"/> <b>Steel Tape</b>
Static Water Level (A): _____ Feet Below Land Surface	Other (specify): _____
Pumping Water Level (B): _____ Feet Below Land Surface	For flowing well, measured shut in head: _____ feet
Drawdown [(B) - (A)]: _____ Feet Below Land Surface	Well yielded _____ GPM with a drawdown of _____ feet after _____ hours of pumping
Test Pumping Rate: _____ Gallons Per Minute	
Duration of Pump Test (minimum 4 hours): _____ hours	

I HEREBY CERTIFY that the above statements are true to the best of my knowledge.

Brad Fitzgerald 0296 Brad Fitzgerald  
 Print Name of Pump Installer and License No. (if applicable) Signature of Pump Installer

Form: OLWR-SWR-1B  
**RECEIVED**  
 MAR 05 2007  
 BY: OLWE