

close to Waltham <sup>LIVR</sup>

# STATE WELL REPORT

## Part 1

### Driller's Log

Mississippi Department of Environmental Quality  
Office of Land and Water Resources  
P.O. Box 2309  
Jackson, MS 39225-2309  
(601)961-5210  
(601)360-0535 (fax)

#### For Office Use Only:

Well #: C107

Aquifer: \_\_\_\_\_

E-Log #: \_\_\_\_\_

County: Pike Waltham

Permit #: \_\_\_\_\_

Driller: Fitzgerald H. Wellserve

Date drilling completed: 2-11-16

**State Law requires that this report be prepared by the license holder responsible for the work and filed with the Department at the above address within 30 days of completion of drilling of the well or borehole.**

<b>Well Owner Information</b> (Landowner if borehole is not for a water well)		<b>Well or Borehole Location</b>	
Owner Name: <u>Charles Parent</u>		Latitude: <u>31°14'22.7"</u> Longitude: <u>90°15'19.6"</u>	
Mailing Address: <u>James Quinn Rd.</u>		Method of Lat/Long (check one): Conventional Survey _____,	
<u>Tylertown</u> <u>ms</u>		USGS quad _____, Hand-held GPS _____, Survey-grade GPS _____	
City	State	<u>NE 1/4 SW 1/4, Sec 12</u>	T _____ R _____
Telephone No. (____) _____		_____ Miles _____ of _____	_____ (Nearest Town)
		(Distance)	(Direction)

**Well / Borehole Data**

Date drilling started: 2-11-16 Date drilling completed: 2-11-16 Hole depth: 180' Hole diameter: 8"

Location of the source of any surface water used for drilling: \_\_\_\_\_

Method of dosing and volume of Chlorine used in drilling and development: \_\_\_\_\_

Logs run (circle all applicable):  No log run  Electric  Gamma Ray  Density  Sonic  Neutron  Other: \_\_\_\_\_

Name of organization running log(s): \_\_\_\_\_

Purpose of borehole (circle one):  Water Well  Geotechnical/Geological Investigation  Ground Source Heat Pump

Seismic Survey Other (describe) \_\_\_\_\_

*If drilling is not related to water well construction, skip the remainder of this block*

Purpose of Well (circle all applicable):  Home  Industrial  Public Supply  Irrigation  Fish Culture

Other (describe): \_\_\_\_\_

If a flowing well, method of flow regulation: Valve \_\_\_\_\_ Other (describe) \_\_\_\_\_

Static Water Level: 105' feet [above or below] land surface Date measured: 2-11-16  
(circle one)

Method of measurement (circle one):  Steel tape  Electric tape  Air line Other (describe): \_\_\_\_\_

Well depth: 180' Well grouted to a depth of: 10' feet Type of grout (circle one):  Neat Cement  Bentonite  Mix

Casing length: 170' feet Casing diameter: 4" inches Type of casing: PVC

Screen length: 10' feet Screen diameter: 4" inches Type of screen: PVC

Screen slot size: .010 inches Setting depth: From 170' feet to 180' feet

Type of completion (circle all applicable):  Gravel packed  Underreamed  Open hole  Natural Development

Other (describe): \_\_\_\_\_

Top of lap pipe or reduction in casing: \_\_\_\_\_ feet

*If telescoped or more than one screen, describe on next page*

MAR 23 2016

The sketch below only required for water wells

If well telescopes, show depths on sketch.  
Ground Level →

Description of formations encountered must be provided for all wells and boreholes, unless specifically exempted by regulations

Description of Formations Encountered	From (depth)		To (depth)	
	Ground Level			
Clay	0	20		
Clay	20	40		
Sand	40	80		
Clay	80	90		
Sand	90	120		
Clay	120	160		
Sand	160	170		
Coarse Sand	170	180		

If more than one screen, show location of each on sketch

Sketch the property layout and include the following: 1) the well location; 2) any permanent structures on the property that may aid in locating the well; 3) any roads, power lines, or other items that may aid in locating the property and the well; 4) a north arrow.

Landowner Name: Charles Parent

Form: OLWR-SWR-1A (04/08)

I certify that the well/borehole was drilled, constructed, and completed in accordance with all applicable requirements of the Mississippi Department of Environmental Quality and the Mississippi Department of Health regulations, if applicable, and state laws.

Brad Fitzgerald 024  
Print Name of Responsible Licensee and License No.

2-11-16  
Date

[Signature]  
Signature of Licensee

# STATE WELL REPORT

## Part 2

**Pump Installer's Completion Report**  
 Mississippi Department of Environmental Quality  
 Office of Land and Water Resources  
 P.O. Box 2309  
 Jackson, MS 39225  
 (601)961-5210  
 (601)961-5228 (fax)

County: Pike  
 Permit #: \_\_\_\_\_  
 Driller: Fitzgerald Well Serv.  
 Date completed: 2-11-16.  
*Copy information from block on Part 1*

**For Office Use Only:**

Aquifer: \_\_\_\_\_  
 Well #: C167  
 Elevation: \_\_\_\_\_

*This part of the report must be completed by a licensed water well contractor or a licensed pump installer. A copy of Part 1 of the report must be attached and both parts filed with the Department at the above address within 30 days of well completion.*

Well Owner Information	Well Location
Owner Name: <u>Charles Parent</u>	Latitude: <u>31°14'22.7"</u> Longitude: <u>90°15'19.6"</u>
Mailing Address: <u>James Quin Rd.</u>	Method of Lat/Long (check one): Conventional Survey _____
<u>Tylabun</u> MS	USGS quad _____, Hand-held GPS _____, Survey-grade GPS _____
City State Zip Code	_____ 1/4 _____ 1/4 Sec _____ T _____ R _____
Telephone No. ( ) _____	Distance _____ Direction _____ Nearest Town _____
	_____ Miles _____ of _____

Pump Type Circle one	Power Type Circle one
Air Lift <input type="checkbox"/> Jet <input type="checkbox"/> <b>Submersible</b> <input checked="" type="checkbox"/>	Diesel Engine <input type="checkbox"/> Gasoline Engine <input type="checkbox"/> Natural Gas <input type="checkbox"/>
Bucket <input type="checkbox"/> Piston <input type="checkbox"/> Turbine <input type="checkbox"/>	<b>Electric Motor</b> <input checked="" type="checkbox"/> Hand <input type="checkbox"/> Tractor PTO <input type="checkbox"/>
Centrifugal <input type="checkbox"/> Rotary <input type="checkbox"/> Flowing Well <input type="checkbox"/>	Windmill <input type="checkbox"/> Other (specify): _____
Other (specify): _____	Horse Power Rating of Motor: <u>3/4</u>
Date Pump Installed: <u>2-11-16.</u>	Setting Depth: <u>150'</u> feet
Rated Pump Capacity: <u>12</u> Gallons Per Minute	Number of Stages: <u>12</u>

Pump Test Data	Method of Measuring Water Level Circle one
Date Well Tested: _____	Air Line <input type="checkbox"/> Electric Measuring Line <input type="checkbox"/> <b>Steel Tape</b> <input checked="" type="checkbox"/>
Static Water Level (A): _____ Feet Below Land Surface	Other (specify): _____
Pumping Water Level (B): _____ Feet Below Land Surface	For flowing well, measured shut in head: _____ feet
Drawdown [(B) - (A)]: _____ Feet Below Land Surface	Well yielded _____ GPM with a drawdown of _____
Test Pumping Rate: _____ Gallons Per Minute	_____ feet after _____ hours of pumping
Duration of Pump Test (minimum 4 hours): _____ hours	

This is for (circle one): **New Well**  Replacement of Existing Pump  Repair of Existing Pump

I HEREBY CERTIFY that the above statements are true to the best of my knowledge.

Brad Fitzgerald 029 [Signature]  
 Print Name of Pump Installer and License No. (if applicable) Signature of Pump Installer


Form: OLWR-SWR-1C (07-09)

MAR 28 2016

OLWR

C147

Google Maps 31°14'22.7"N 90°15'19.6"W

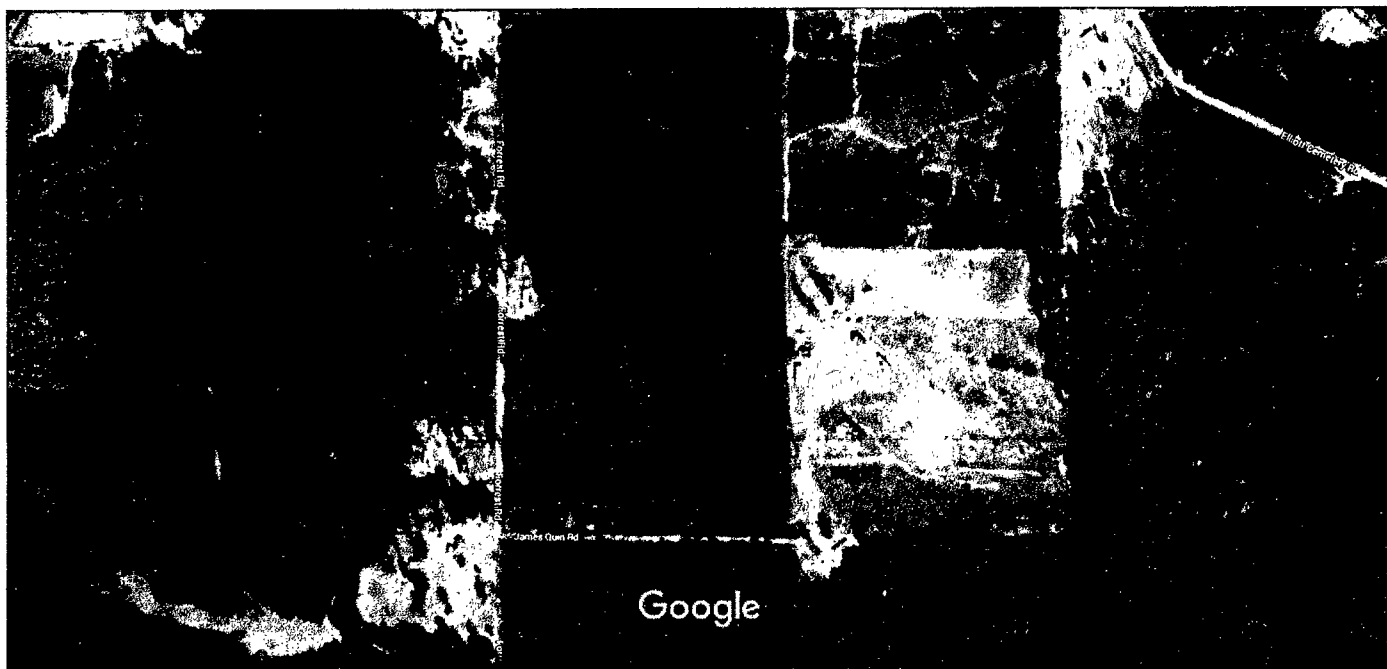

Imagery ©2016 Google, Map data ©2016 Google 200 ft

31°14'22.7"N 90°15'19.6"W

Google Maps

Charles Parent  
 James Quinn Rd off Fossil Rd

2-11-16 3/4 HP 180'

RECEIVED  
 MAR 20 2016

MAR 20 2016

RECEIVED