

Walthall
 C 2002
 11-20-75

MISSISSIPPI
 BOARD OF WATER COMMISSIONERS
 416 North State Street
 Jackson, Mississippi 39201

WATER WELL DRILLERS LOG

11-20
 date well completed

134

19 75 Fitzgerald & Son
 firm name

Walthall
 county well located

LANDOWNER:
 Wilbert Jones
 R.R. Tylburn
 (mailing address)

WELL LOCATION:
 sec. 31 T. 3 N. R. 10 E
 6 miles W of Tylburn
 (distance) (direction) (nearest town)

description of formations encountered	from	to
Red clay	0	20
Red sand & gravel	20	80
white clay	80	120
Red gravel	120	135
Coarse sand & gravel	135	150

WELL PURPOSE: Home
 (home, irrigation, municipal, industrial)


- WELL COMPLETION DATA:
- (1) diameter (inches) 4
 - (2) total depth (feet) 150
 - (3) static water level (feet) 110 below top of ground.
 - (4) casing plastic 142 (material) (depth)
 4 if telescope see back. (size)
 - (5) screen 8 142 (length) (depth to top)
 4 plastic (size) (material)
 - (6) pump 1/2 10 (HP) (yield gpm)
 electric (type power)
 - (7) electric log no (yes or no)
 (organization running log)
 - (8) how well bottom plugged sand shank

DEC 17 1975

DRILLERS REMARKS:

If well telescopes please sketch and show depths.

GROUND LEVEL

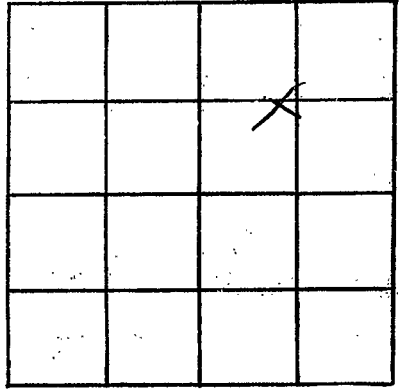

SECTION 31

Please indicate well location X.

ADDITIONAL INFORMATION

If more than one screen, show locations of each on sketch: