

WALTHALL
 C. 2003
 11-22-75

MISSISSIPPI
 BOARD OF WATER COMMISSIONERS
 416 North State Street
 Jackson, Mississippi 39201

WATER WELL DRILLERS LOG

Nov 22 1975 *Remer Well Dr* *Walthall*
 date well completed firm name county well located

LANDOWNER:
Ada Mae Jones
Rt. 2 Tylertown
 (mailing address)

description of formations encountered	from	to
<i>clay</i>	<i>0</i>	<i>20</i>
<i>red sand</i>	<i>20</i>	<i>105</i>
<i>heavy sandstone</i>	<i>105</i>	<i>122</i>

WELL LOCATION:
 sec. *11* T. *3* N. R. *10* E.
9 miles *west* of *Tylertown*
 (distance) (direction) (nearest town)

WELL PURPOSE: *home*
 (home, irrigation, municipal, industrial)

- WELL COMPLETION DATA:
- (1) diameter (inches) *4"*
 - (2) total depth (feet) *122*
 - (3) static water level (feet) *27'* below top of ground.
 - (4) casing *plaster bottom*
 (material) (depth)
 - 1* If telescope see back.
 (size)
 - (5) screen *6"* *116*
 (length) (depth to top)
 - 4"* *plaster*
 (size) (material)
 - (6) pump *1/2* *10*
 (HP) (yield gpm)
 - elect*
 (type power)
 - (7) electric log *no*
 (yes or no)
 - Remer Well Dr*
 (organization running log)

(8) how well bottom plugged:
wooden plug


DRILLERS REMARKS:

RECEIVED
 JAN 28 1976

MISS. BD. OF WATER COM.

If well telescopes please sketch and show depths.

GROUND LEVEL

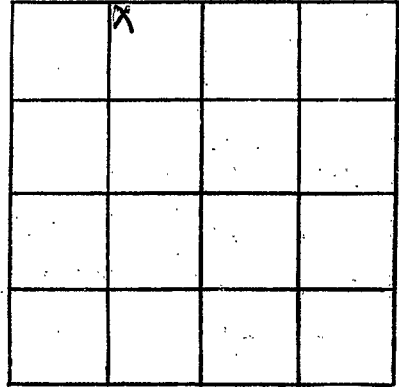

SECTION 11

Please indicate well location X.

ADDITIONAL INFORMATION

If more than one screen, show locations of each on sketch.