

Walthall
 C 2004
 11-26-75

MISSISSIPPI
 BOARD OF WATER COMMISSIONERS
 416 North State Street
 Jackson, Mississippi 39201

WATER WELL DRILLERS LOG


26 Nov. 1975 ANDOS Parker Walthall
 date well completed firm name county well located

LANDOWNER:	description of formations encountered	from	to
Claud McKelpin Tylertown (mailing address)			
WELL LOCATION: sec. <u>31</u> T. <u>3</u> N R. <u>10</u> E <u>10</u> miles <u>NW</u> of <u>Ty</u> (distance) (direction) (nearest town)			
WELL PURPOSE: (home, irrigation, municipal, industrial)			
WELL COMPLETION DATA: (1) diameter (inches) <u>4</u> (2) total depth (feet) <u>114</u> (3) static water level (feet) <u>85</u> below above top of ground. (4) casing <u>PI</u> <u>108</u> (material) (depth) (size) if telescope see back. (5) screen <u>6</u> <u>108</u> (length) (depth to top) <u>4</u> <u>PI</u> (size) (material) (6) pump <u>1/2</u> <u>8</u> (HP) (yield gpm) <u>elit</u> (type power) (7) electric log _____ (organization running log) (8) how well bottom plugged <u>wood</u>			
DRILLERS REMARKS:			

DEC 15 1975
 MISS. BD. OF WATER COMMISSIONERS

If well telescopes please sketch and show depths.

GROUND LEVEL

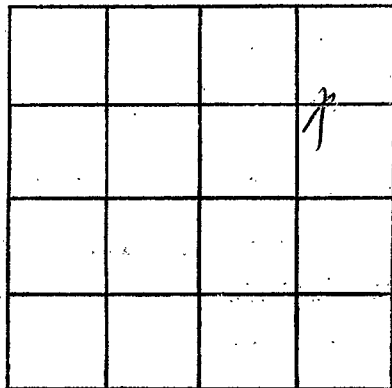

SECTION 31

Please indicate well location X.

ADDITIONAL INFORMATION

If more than one screen, show locations of each on sketch.