

Walthall  
 C 2005  
 12/5/75

134

MISSISSIPPI  
 BOARD OF WATER COMMISSIONERS  
 416 North State Street  
 Jackson, Mississippi 39201

WATER WELL DRILLERS LOG

12-5 1975 BRIVER-BIOW WALTHALL  
 date well completed firm name county well located

LANDOWNER:  
 Katie Barnes  
 Tylertown, Miss.  
 (mailing address)

WELL LOCATION:  
 sec 31 T 3 N R 9 E  
 7 miles W of Tylertown  
 (distance) (direction) (nearest town)

description of formations encountered	from	to
Topsoil	0	6
Clay	6	10
Shale	10	23
Chalk	23	92
Sand & Gravel	92	184
Sand	184	310

WELL PURPOSE: Home  
 (home, irrigation, municipal, industrial)

WELL COMPLETION DATA:

(1) diameter (inches) 2"

(2) total depth (feet) 310

(3) static water level (feet) 205 below above top of ground.

(4) casing PVC, 300, (material) (depth)  
 2" (size) if telescope see back.


(5) screen 10', 300 (length) (depth to top)  
 2" PVC (size) (material)

(6) pump 1 9 (HP) (yield gpm)  
 elec (type power)

(7) electric log 100 (yes or no)

(organization running log)

(8) how well bottom plugged  
 Blow Valve

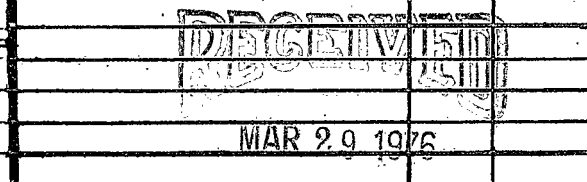


DRILLERS REMARKS:

MAR 29 1976

If well telescopes please  
sketch and show depths.

GROUND LEVEL

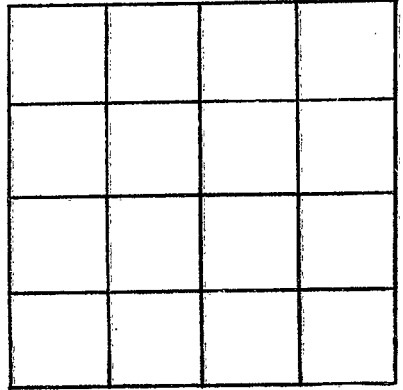

SECTION \_\_\_\_\_

Please indicate well location X.

ADDITIONAL INFORMATION

If more than one screen,  
show locations of each on sketch.