

WALTHALL

C 2557

3-12-76

1301

MISSISSIPPI BOARD OF WATER COMMISSIONERS
416 North State Street
Jackson, Mississippi 39201

WATER WELL DRILLERS LOG

Walthall

12 March 1976

J. J. Cooney & Co.

firm name

county well located

LANDOWNER:

Clard Helms
Tylerton

(mailing address)

description of formations encountered

from

to

clay	0	25
sand shale	25	40
sand	40	55
clay	55	145
sand	145	180

WELL LOCATION:

sec. 31 T 3 N R 10 E
6 miles (distance) S (direction) of Tylerton (nearest town)


WELL PURPOSE:

(home, irrigation, municipal, industrial)

WELL COMPLETION DATA:

- (1) diameter (inches) 4
- (2) total depth (feet) 130
- (3) static water level (feet) 90 below top of ground.
- (4) casing (material) PL (depth) 174
- (size) If telescope see back.
- (5) screen 6 (length) 174 (depth to top)
- (size) 4 (material) PL
- (6) pump (HP) Walthall Pump (yield gpm)
- (type power)
- (7) electric log (yes or no)
- (organization running log)
- (8) how well bottom plugged wood

DRILLERS REMARKS:

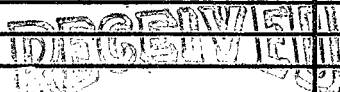


APR 23 1976

MISS. BD. OF WATER COMMISSIONERS

If well telescopes please sketch and show depths.

GROUND LEVEL

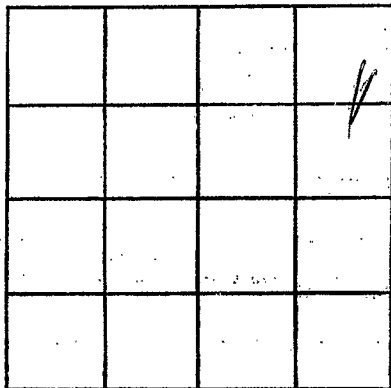

SECTION 31

Please indicate well location X.

ADDITIONAL INFORMATION

If more than one screen, show locations of each on sketch.