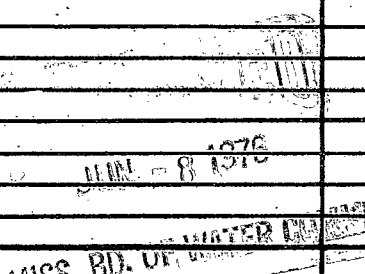


Walhall
 C 2008
 3/22/76

MISSISSIPPI
 BOARD OF WATER COMMISSIONERS
 416 North State Street
 Jackson, Mississippi 39201


WATER WELL DRILLERS LOG

March 22 1976 ~~Remm...~~ Walhall
 date well completed firm name county well located

LANDOWNER:	description of formations encountered	from	to
Janaka Thunter	Red Clay	0	22
Rt 3 Tylitown (mailing address)	Red sand & gravel Gravel	22	112
WELL LOCATION: sec. 12 T 3 N R 9 E 1 miles west of Union (distance) (direction) (nearest town)			
WELL PURPOSE: Home (home, irrigation, municipal, industrial)			
WELL COMPLETION DATA: (1) diameter (inches) 4" (2) total depth (feet) 122 (3) static water level (feet) 90 below top of ground. (4) casing plaster, bottom (material) (depth) (size) if telescope see back. (5) screen 6' 122 (length) (depth to top) 1/2" plaster (size) (material) (6) pump 1/2 Sub 10 (HP) (yield gpm) (type power) (7) electric log no (yes or no) (organization running log)			
(8) how well bottom plugged wooden plug			
DRILLERS REMARKS: no present well			

If well telescopes please sketch and show depths.

GROUND LEVEL

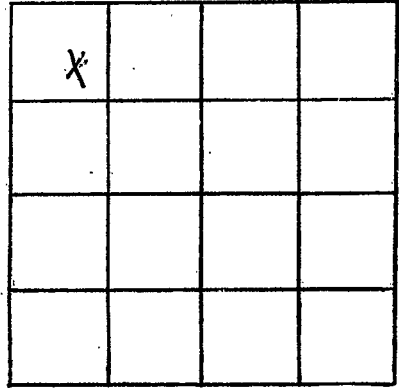

SECTION 12

Please indicate well location X.

ADDITIONAL INFORMATION

If more than one screen, show locations of each on sketch.