

Walshall
C 2010
6/8/76

MISSISSIPPI
 BOARD OF WATER COMMISSIONERS
 416 North State Street
 Jackson, Mississippi 39201

134

WATER WELL DRILLERS LOG

June 8 1976 Rever Well Ser Walshall
 date well completed firm name county well located

LANDOWNER:
J. W. Magee Jr.
Rt 3 Tylertown
 (mailing address)

description of formations encountered	from	to
	<u>Clay</u>	<u>0</u>
<u>Red sand</u>	<u>20</u>	<u>35</u>
<u>Red Chalk</u>	<u>35</u>	<u>65</u>
<u>sand & gravel</u>	<u>65</u>	<u>90</u>
<u>Red Chalk</u>	<u>90</u>	<u>100</u>
<u>Red gravel & sand</u>	<u>100</u>	<u>118</u>

WELL LOCATION:
 sec. 10 T. 3 N R. 10 E
9 1/2 miles N-NW of Tylertown
 (distance) (direction) (nearest town)

WELL PURPOSE: Trailer
 (home, irrigation, municipal, industrial)

WELL COMPLETION DATA:

(1) diameter (inches) 4"

(2) total depth (feet) 118

(3) static water level (feet) 91 below above top of ground.

(4) casing plastic (material) scattered (depth)

1" If telescope see back. (size)

(5) screen 6' (length) 112' (depth to top)

4" (size) plastic (material)

(6) pump 2 1/2 (HP) 10 (yield gpm)

elect (type power)

(7) electric log no (yes or no)

(organization running log)


(8) how well bottom plugged
wooden plug

DRILLERS REMARKS:
new trailer site

RECEIVED
 OCT - 7 1976

If well telescopes please sketch and show depths.

GROUND LEVEL

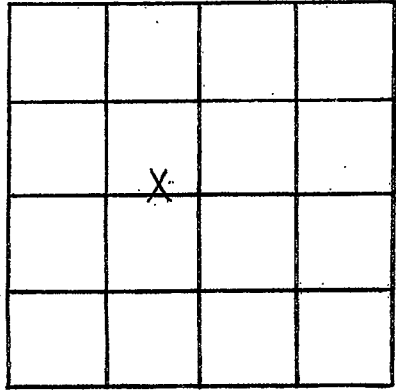

SECTION 10

Please indicate well location X.

ADDITIONAL INFORMATION

If more than one screen, show locations of each on sketch.