

WALTHALL
 C 2011
 6-15-76

MISSISSIPPI
 BOARD OF WATER COMMISSIONERS
 416 North State Street
 Jackson, Mississippi 39201

WATER WELL DRILLERS LOG

6-15 1976 *Fitzgibbon Well Dr* *Walthall*
 date well completed firm name county well located

LANDOWNER:
Richard Fail
R.R. Lydton, Miss.
 (mailing address)

description of formations encountered	from	to
<i>Red clay</i>	<i>6</i>	<i>20</i>
<i>Red sand</i>	<i>20</i>	<i>115</i>
<i>Coarse sand & gravel</i>	<i>115</i>	<i>128</i>

WELL LOCATION:
 sec. 22 T. 3 N. R. 10 E.
6 miles *N* of *Lydton*
 (distance) (direction) (nearest town)

WELL PURPOSE: *Home*
 (home, irrigation, municipal, industrial)


- WELL COMPLETION DATA:
- (1) diameter (inches) 4
 - (2) total depth (feet) 128
 - (3) static water level (feet) 90 below above top of ground.
 - (4) casing PVC, 120,
 (material) (depth)
4 if telescope see back.
 (size)
 - (5) screen 8, 120
 (length) (depth to top)
4, PVC
 (size) (material)
 - (6) pump 1/2, 10
 (HP) (yield gpm)
elec
 (type power)
 - (7) electric log no
 (yes or no)
 (organization running log)
 - (8) how well bottom plugged Fuller

DRILLERS REMARKS:

MISSISSIPPI
 BOARD OF WATER COMMISSIONERS
 JUL 2 1976
 MISS. BU. OF WATER COMMISSIONERS

If well telescopes please sketch and show depths.

GROUND LEVEL

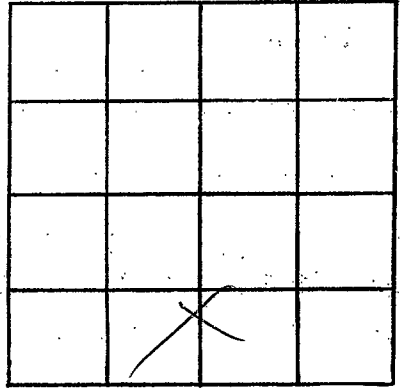

SECTION 22

Please indicate well location X.

ADDITIONAL INFORMATION

A series of horizontal lines for recording additional information.

If more than one screen, show locations of each on sketch.