

WALTHALL
C 2012
6-23-76

MISSISSIPPI
 BOARD OF WATER COMMISSIONERS
 416 North State Street
 Jackson, Mississippi 39201

WATER WELL DRILLERS LOG

6-23 ¹³⁰⁴ 1976 Flygarden Well Dr Walthall
 date well completed firm name county well located

LANDOWNER:
London Bearden
R.R. Tyler
 (mailing address)

description of formations encountered	from	to
Red clay	0	20
Red silt	20	115
Coarse sand & gravel	115	128

WELL LOCATION:
 sec. 22 3 N S R. 10 E W
7 miles N of Tyler
 (distance) (direction) (nearest town)

WELL PURPOSE:
Home
 (home, irrigation, municipal, industrial)


- WELL COMPLETION DATA:
- (1) diameter (inches) 4
 - (2) total depth (feet) 128
 - (3) static water level (feet) 95 below above top of ground.
 - (4) casing PVC, 120,
 (material) (depth)
4 if telescope see back.
 (size)
 - (5) screen 8, 120
 (length) (depth to top)
4, PVC
 (size) (material)
 - (6) pump 1/2, 10
 (HP) (yield gpm)
elec
 (type power)
 - (7) electric log Yes
 (yes or no)
 (organization running log)
 - (8) how well bottom plugged Seal thick

DRILLERS REMARKS:

MISSISSIPPI
 BOARD OF WATER COMMISSIONERS
 JUL - 1 1976
 MISS. DR. OF

If well telescopes please sketch and show depths.

GROUND LEVEL

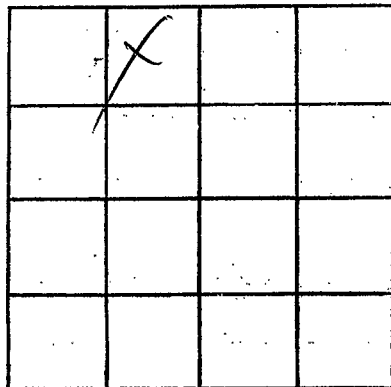

SECTION 22

Please indicate well location X.

ADDITIONAL INFORMATION

If more than one screen, show locations of each on sketch.