

Walthall
C 2014
9/22/76

MISSISSIPPI
 BOARD OF WATER COMMISSIONERS
 416 North State Street
 Jackson, Mississippi 39201

WATER WELL DRILLERS LOG

9-22
 date well completed

132 76 Feltman well
 firm name


Walthall
 county well located

LANDOWNER:	description of formations encountered	from	to
<u>Andrew Jones</u>			
<u>R.R. Feltman</u> (mailing address)	<u>Red clay</u>	<u>0</u>	<u>20</u>
	<u>Red sand</u>	<u>20</u>	<u>95</u>
	<u>Coarse sand & gravel</u>	<u>95</u>	<u>120</u>
WELL LOCATION:			
sec. <u>27</u> T. <u>3</u> N. R. <u>10</u> E			
<u>5</u> miles <u>N</u> of <u>Feltman</u>			
(distance) (direction) (nearest town)			
WELL PURPOSE: <u>Home</u> (home, irrigation, municipal, industrial)			
WELL COMPLETION DATA:			
(1) diameter (inches) <u>4</u>			
(2) total depth (feet) <u>120</u>			
(3) static water level (feet) <u>80</u> below above top of ground.			
(4) casing <u>PVC</u> , <u>112</u> , (material) (depth)			
<u>4</u> (size) If telescope see back.			
(5) screen <u>8</u> , <u>112</u> (length) (depth to top)			
<u>4</u> , <u>PVC</u> (size) (material)			
(6) pump <u>1/2</u> , <u>10</u> (HP) (yield gpm)			
<u>Electric</u> (type power)			
(7) electric log <u>No</u> (yes or no)			
(organization running log)			
(8) how well bottom plugged <u>Sand plug</u>			
DRILLERS REMARKS:			

RECEIVED
 OCT 18 1976
 MISS. BD. OF WATER COMMISSIONERS

If well telescopes please sketch and show depths.

GROUND LEVEL

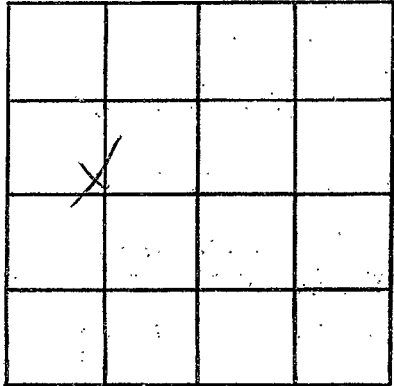

SECTION 27

Please indicate well location X.

ADDITIONAL INFORMATION

If more than one screen, show locations of each on sketch.