

WALTHALL

C 2015

9-23-76

1324

MISSISSIPPI BOARD OF WATER COMMISSIONERS
416 North State Street
Jackson, Mississippi 39201

WATER WELL DRILLERS LOG

9-23 1976
date well completed


F. G. ...
firm name

Walthall
county well located

LANDOWNER:	description of formations encountered	from	to
Leslie James			
P.O. Box ... (mailing address)	Red clay Red sand Coarse sand & gravel	0 20 40	20 40 55
WELL LOCATION:			
sec. 33 T. 30 N. R. 10 E S W 17 miles NW of ... (distance) (direction) (nearest town)			
WELL PURPOSE: Home (home, irrigation, municipal, industrial)			
WELL COMPLETION DATA:			
(1) diameter (inches) 4			
(2) total depth (feet) 55			
(3) static water level (feet) 8 below above top of ground.			
(4) casing PVC, 4" (material) (depth)			
4 (size) If telescope see back.			
(5) screen 8, 4" (length) (depth to top)			
4 (size) PVC (material)			
(6) pump 1/2 (HP) 10 (yield gpm)			
Electric (type power)			
(7) electric log No (yes or no)			
(organization running log)			
(8) how well bottom plugged Sand block			
DRILLERS REMARKS:			

If well telescopes please sketch and show depths.

GROUND LEVEL

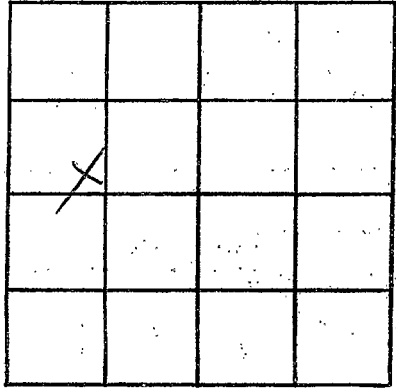

SECTION

33

Please indicate well location. X.

ADDITIONAL INFORMATION

If more than one screen, show locations of each on sketch.