

Walthall
C. 2014
10-11-76

MISSISSIPPI
 BOARD OF WATER COMMISSIONERS
 416 North State Street
 1381 Jackson, Mississippi 39201

WATER WELL DRILLERS LOG

10-11 1976 St. Gabriel Well Serv Walthall
 date well completed firm name county well located

LANDOWNER:
Nancy Beaufield
Robt. Lybster
 (mailing address)

WELL LOCATION:
 sec. 1 T. 3 N. R. 10 E.
9 miles N of Lybster
 (distance) (direction) (nearest town)

WELL PURPOSE:
 (home, irrigation, municipal, industrial) Home

WELL COMPLETION DATA:

(1) diameter (inches) 4

(2) total depth (feet) 180

(3) static water level (feet) 120 below above top of ground.

(4) casing PVC, 172,
 (material) (depth)
4 If telescope see back.
 (size)

(5) screen 8, 172
 (length) (depth to top)
4 PVC
 (size) (material)

(6) pump 1/2, 10
 (HP) (yield gpm)
elec
 (type power)

(7) electric log no
 (yes or no)
 (organization running log)

(8) how well bottom plugged Sealed


description of formations encountered	from	to
<u>Red clay</u>	<u>0</u>	<u>20</u>
<u>Red sand</u>	<u>20</u>	<u>80</u>
<u>Red gravel</u>	<u>80</u>	<u>120</u>
<u>Red sand</u>	<u>120</u>	<u>170</u>
<u>Coarse sand & gravel</u>	<u>170</u>	<u>180</u>

DRILLERS REMARKS:

RECEIVED
 OCT 28 1976
 MISS. BD. OF WATER COMMISSIONERS

If well telescopes please sketch and show depths.

GROUND LEVEL

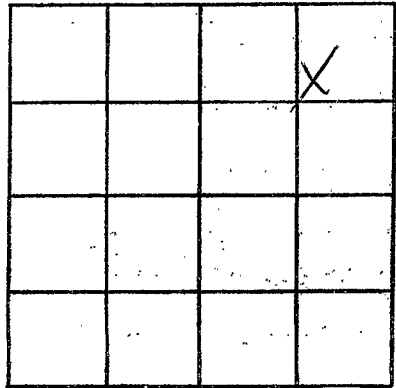

SECTION 1

Please indicate well location X.

ADDITIONAL INFORMATION

If more than one screen,
show locations of each on sketch.