

WALTHALL
 C 2007
 2/10/77

MISSISSIPPI
 BOARD OF WATER COMMISSIONERS
 416 North State Street
 Jackson, Mississippi 39201

WATER WELL DRILLERS LOG

Feb. 10 1977 Brentfield well Walthall
 date well completed firm name county well located

LANDOWNER: Bobby Walker
Tylertown
MISS
 (mailing address)

WELL LOCATION:
 sec. 32 T. 3 N R. 10 E
6 miles N.W. of Tylertown
 (distance) (direction) (nearest town)

WELL PURPOSE: Home
 (home, irrigation, municipal, industrial)

- WELL COMPLETION DATA:
- (1) diameter (inches) 4"
 - (2) total depth (feet) 136
 - (3) static water level (feet) 108 below top of ground.
 - (4) casing Plastic 125
 (material) (depth)
4" if telescope see back.
 (size)
 - (5) screen 10' 125
 (length) (depth to top)
4" Plastic
 (size) (material)
 - (6) pump 1/2 6
 (HP) (yield gpm)
Electric
 (type power)
 - (7) electric log no
 (yes or no)

(organization running log)
 (8) how well bottom plugged Sandshack

DRILLERS REMARKS:

description of formations encountered	from	to
CLAY	0	21
SAND	21	29
GRAVEL	29	38
CHALK	38	59
SANDY CLAY	59	91
SAND	91	123
SAND & GRAVEL	123	136


RECEIVED

MAR 21 1978

MISS. BD. OF WATER COMMISSIONERS

If well telescopes please sketch and show depths.

GROUND LEVEL

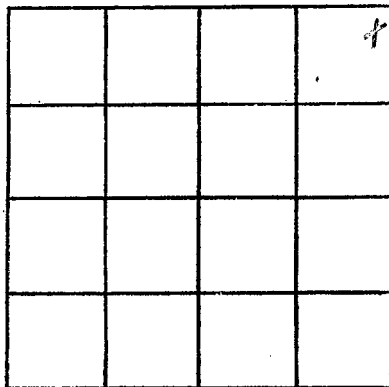

SECTION 32

Please indicate well location X.

ADDITIONAL INFORMATION

If more than one screen,
show locations of each on sketch.