

WALTHALL  
 C 2018  
 May 21, 1977

MISSISSIPPI  
 BOARD OF WATER COMMISSIONERS  
 416 North State Street  
 13N Jackson, Mississippi 39201

48

WATER WELL DRILLERS LOG

May 21 1977 Reverwellers Walthall  
 date well completed firm name county well located

LANDOWNER:  
Edward Payton  
Rt 3 Tylertown  
 (mailing address)

description of formations encountered	from	to
<u>Red Clay</u>	<u>0</u>	<u>22</u>
<u>Chalky sand</u>	<u>22</u>	<u>50</u>
<u>White &amp; Yellow Chalk</u>	<u>50</u>	<u>115</u>
<u>Sand &amp; Gravel</u>	<u>115</u>	<u>145</u>

WELL LOCATION:  
 sec. 12 T. 3 N R. 9 E  
10 miles N-NW of Tylertown  
 (distance) (direction) (nearest town)

WELL PURPOSE: home  
 (home, irrigation, municipal, industrial)

WELL COMPLETION DATA:  
 (1) diameter (inches) 4"  
 (2) total depth (feet) 145  
 (3) static water level (feet) \_\_\_\_\_ below above  
 top of ground.  
 (4) casing plastic bottom  
 (material) (depth)  
 \_\_\_\_\_ if telescope see back.  
 (size)  
 (5) screen 5' 140'  
 (length) (depth to top)  
4" plastic  
 (size) (material)  
 (6) pump 1/2 10  
 (HP) (yield gpm)  
least  
 (type power)  
 (7) electric log NO  
 (yes or no)  
 \_\_\_\_\_  
 (organization running log)

(8) how well bottom plugged  
wooden plug


DRILLERS REMARKS:  
2" well well  
out

RECEIVED  
 AUG 20 1977

MISS. Bd. of WATER COMMISSIONERS

If well telescopes please sketch and show depths.

GROUND LEVEL

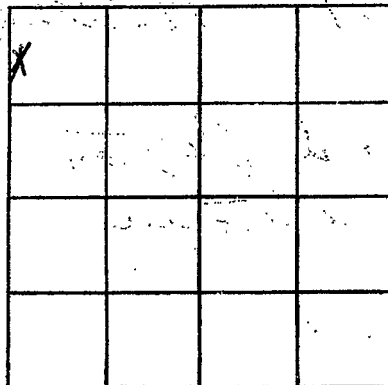

SECTION 12

Please indicate well location X.

ADDITIONAL INFORMATION

If more than one screen,  
show locations of each on sketch.