

Walthall
C 209
6-3-77

MISSISSIPPI
 BOARD OF WATER COMMISSIONERS
 416 North State Street
 Jackson, Mississippi 39201

(59)

WATER WELL DRILLERS LOG

June 3 1977 Rees Miller Walthall
 date well completed firm name county well located

LANDOWNER:
Bobbie Sencin
Rt 3 Tylotown
 (mailing address)

description of formations encountered	from to	
<u>Red Clay</u>	<u>0</u>	<u>18</u>
<u>Red sand</u>	<u>18</u>	<u>40</u>
<u>Sand & Gravel</u>	<u>40</u>	<u>55</u>
<u>lobble</u>	<u>55</u>	<u>70</u>
<u>gravelly sand</u>	<u>70</u>	<u>82</u>

WELL LOCATION:
 sec. 25 T 3 N R 10 E
5 1/2 miles north of Tylotown
 (distance) (direction) (nearest town)

WELL PURPOSE: home
 (home, irrigation, municipal, industrial)

- WELL COMPLETION DATA:
- (1) diameter (inches) 4"
 - (2) total depth (feet) 82
 - (3) static water level (feet) 60 below above top of ground.
 - (4) casing plastic bottom
 (material) (depth)
— if telescope see back.
 (size)
 - (5) screen 5" 77'
 (length) (depth to top)
4" plastic
 (size) (material)
 - (6) pump 2 10
 (HP) (yield gpm)
elect
 (type power)
 - (7) electric log no
 (yes or no)
- (organization running log)

(8) how well bottom plugged
wooden plug


DRILLERS REMARKS:
—

RECEIVED
 JUN 21 1977

MISS. BLD. OF WATER COMMISSIONERS

If well telescopes please
sketch and show depths.

GROUND LEVEL

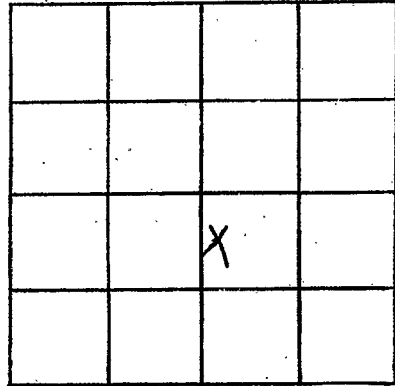

SECTION 25

Please indicate well location X.

ADDITIONAL INFORMATION

If more than one screen,
show locations of each on sketch.