

72

WALTHALL  
C 2001  
6-25-77

MISSISSIPPI  
BOARD OF WATER COMMISSIONERS  
416 North State Street  
1326 Jackson, Mississippi 39201

WATER WELL DRILLERS LOG

June 25 1977 Reems well ser Walthall  
date well completed firm name county well located

LANDOWNER:  
Ruby Reins  
Rt 5 - Tylertown  
(mailing address)

description of formations encountered	from to	
	from	to
<u>Red Clay</u>	<u>0</u>	<u>20</u>
<u>Red sand</u>	<u>20</u>	<u>90</u>
<u>sand &amp; gravel</u>	<u>90</u>	<u>98</u>
<u>Dark Chalk</u>	<u>98</u>	<u>110</u>
<u>Gravelly sand</u>	<u>110</u>	<u>123</u>

WELL LOCATION: North Tylertown  
sec. 2 T-3 N R-12 E  
9 miles north of Tylertown  
(distance) (direction) (nearest town)

WELL PURPOSE: home  
(home, irrigation, municipal, industrial)

WELL COMPLETION DATA:  
(1) diameter (inches) 4"  
(2) total depth (feet) 128  
(3) static water level (feet) 85 below top of ground.  
(4) casing plastic bottom  
(material) (depth)  
(size) if telescope see back.  
(5) screen 5" 123'  
(length) (depth to top)  
4" plastic  
(size) (material)  
(6) pump 1/2 hp 10  
(HP) (yield gpm)  
elect  
(type power)  
(7) electric log no  
(yes or no)  
(organization running log)

(8) how well bottom plugged  
wooden plug


DRILLERS REMARKS:

RECEIVED  
NOV - 9 1977

MISS. BD. OF WATER COMMISSIONERS

If well telescopes please sketch and show depths.

GROUND LEVEL

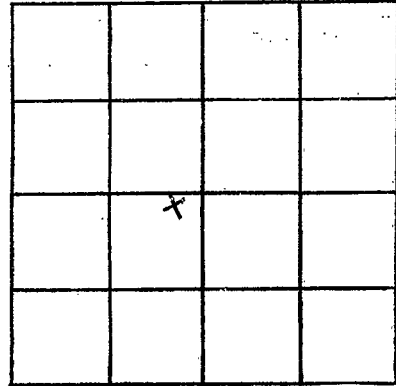

SECTION 2

Please indicate well location X.

ADDITIONAL INFORMATION

If more than one screen, show locations of each on sketch.